IREDELL COUNTY HEALTH DEPARTMENT - *ENVIRONMENTAL HEALTH* ☒ STATESVILLE OFFICE 704-878-5305 ☐ MOORESVILLE OFFICE 704-664-5281

IMPROVEMENT PERMIT / AUTHORIZATION TO CONSTRUCT / OPERATION PERMIT / EXISTING SYSTEM INSPECTION

PERMIT # 169875 PIN # 4712-27-4202 DATE 12-28-11

OWNER Janie Land APPLICANT: Freedom Homes PHONE: Home/Cell # 704-883-6145 Business #

SITE ADDRESS 489 Celeste Eutola OWNER / APPLICANT ADDRESS 489 Celeste Eutola

SITE DIRECTIONS I-40 to Old Mtn Rd, turn south. (R) on Celeste Eutola Rd, lot on left.

SUBDIVISION n/a BLOCK / SECTION n/a LOT # n/a LOT AREA .64 DESIGN FLOW 240 L.T.A.R. Ex.

Septic Tank Ex. Gallons: STB Date

Pump Tank Gallons: P T Date

Pump Make Model Serial #

No. Nitrification Fields: 1 No. Lines 3 Linear Feet 200 total

Trench Width 36" Max. Trench Bottom Depth 36" Gravel Depth n/a

☒ New System ☐ Repair ☐ Expansion System Type I II (III) IV V VI

System Description: 25% Reduction HDMS

Repair System Description: 50% Reduction

Maintenance Agreement Required ☐ YES ☒ NO

☒ GRAVITY ☐ PRESSURE

☒ Residence No. Bedrooms 2

☐ Business No. Persons

☐ Other No. Employees

☐ Slab ☒ Crawl Space


☐ Basement w/plumbing ☐ Basement w/o plumbing

Water Supply: ☐ Private ☒ Public ☐ Community

Comments / Conditions

System altered from 3BR to 2BR

INITIAL SITE SKETCH

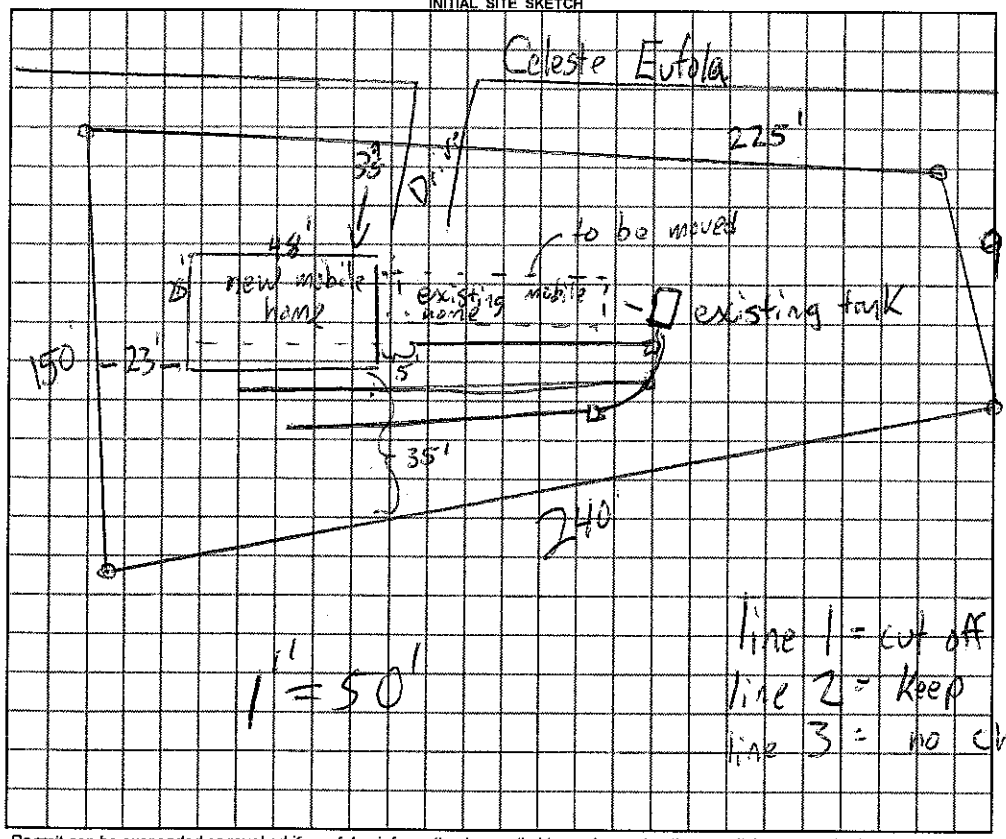

AS BUILT SKETCH

Permit can be suspended or revoked if any false information is supplied toward securing the permit / any unauthorized changes are made to the site / any unauthorized changes are made in the installation of the system.

☐ *IMPROVEMENT PERMIT* with plat valid without expiration. ☐ *IMPROVEMENT PERMIT* with plat valid without expiration. site plan valid 5 years ☐ *AUTHORIZATION TO CONSTRUCT* valid for period equal to IMPROVEMENT PERMIT--not to exceed 60 mo.

Owner / Applicant Signature: Date 12-28-11 Installed by: A-1 Backhoe

IMPROVEMENT PERMIT by: REHS Date 12-28-11 OPERATION PERMIT by: REHS Date 2-15-12

AUTHORIZATION TO CONSTRUCT by: REHS Date 12-28-11 Existing System Inspected by: REHS Date

YOU SHOULD CONTACT A LOCATOR SERVICE PRIOR TO ANY EXCAVATION

White Copy – Environmental Health YELLOW COPY (Final) Owner / Applicant PINK COPY (Initial) Owner / Applicant