IREDELL COUNTY HEALTH DEPARTMENT - *ENVIRONMENTAL HEALTH* ☒ STATESVILLE OFFICE 704-878-5305 ☐ MOORESVILLE OFFICE 704-664-5281

IMPROVEMENT PERMIT / AUTHORIZATION TO CONSTRUCT / OPERATION PERMIT / EXISTING SYSTEM INSPECTION

PERMIT # 169875 PIN # 4712-27-4202 DATE 12-28-11

OWNER Jamie Land APPLICANT: Freedom Homes PHONE: Home/Cell # 704-883-6148 Business #

SITE ADDRESS 489 Celeste Eutola OWNER / APPLICANT ADDRESS 489 Celeste Eutola

SITE DIRECTIONS I-40 to Old Mtn Rd, turn south. (R) on Celeste Eutola Rd., lot on left.

SUBDIVISION n/a BLOCK / SECTION n/a LOT # n/a LOT AREA .64 DESIGN FLOW 240 L.T.A.R. Ex.

Septic Tank Ex. Gallons: STB Date
Pump Tank Gallons: P T Date
Pump Make Model Serial #
No. Nitrification Fields: 1 No. Lines 3 Linear Feet 200 total
Trench Width 36" Max. Trench Bottom Depth 36" Gravel Depth n/a

☒ New System ☐ Repair ☐ Expansion System Type I II (III) IV V VI
System Description: 25% Reduction HDLS
Repair System Description: 50% Reduction
Maintenance Agreement Required ☐ YES ☒ NO
☒ GRAVITY ☐ PRESSURE


☒ Residence No. Bedrooms 2
☐ Business No. Persons
☐ Other No. Employees
☐ Slab ☒ Crawl Space
☐ Basement w/plumbing ☐ Basement w/o plumbing

Water Supply: ☐ Private ☒ Public ☐ Community

Comments / Conditions

System altered from 3BR to 2BR

INITIAL SITE SKETCH

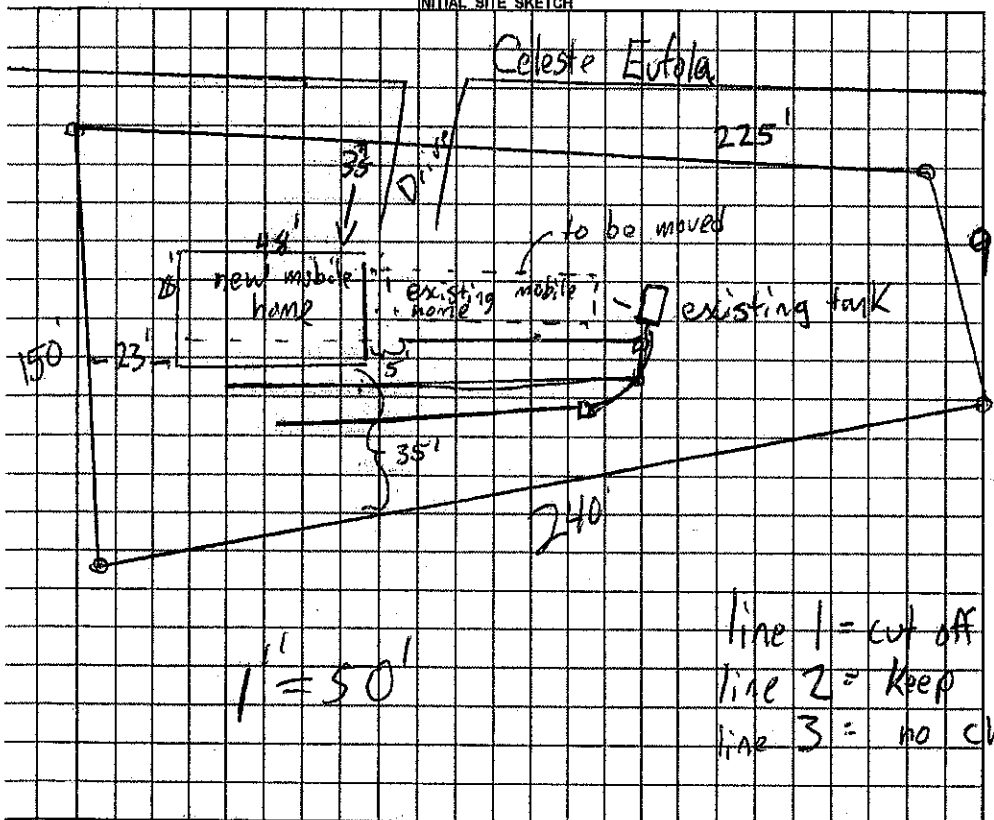

AS BUILT SKETCH

line 1 = cut off 55'
line 2 = keep >5' away from
line 3 = no change building

Permit can be suspended or revoked if any false information is supplied toward securing the permit / any unauthorized changes are made to the site / any unauthorized changes are made in the installation of the system.

☐ ***IMPROVEMENT PERMIT*** with plat valid without expiration. ☐ ***IMPROVEMENT PERMIT*** with plat valid without expiration. ☐ ***AUTHORIZATION TO CONSTRUCT*** valid for period equal to IMPROVEMENT PERMIT--not to exceed 60 mo.

Owner / Applicant Signature: Date 12-28-11 Installed by:

IMPROVEMENT PERMIT by: REHS Date 12-28-11 OPERATION PERMIT by: REHS Date

AUTHORIZATION TO CONSTRUCT by: REHS Date 12-28-11 Existing System Inspected by: REHS Date