IREDELL COUNTY HEALTH DEPARTMENT

STATESVILLE 704-878-5305 MOORESVILLE 704-664-5281

IMPROVEMENT PERMIT / AUTHORIZATION TO CONSTRUCT / OPERATION PERMIT / EXISTING SYSTEM INSPECTION

PERMIT# 071443 PIN# 4712 27 6771 DATE 1-15-98

OWNER OR CONTRACTOR JAMES S. HARTNESS PHONE: Business Home 872-7369

ADDRESS 154 LANAS END DRIVE, STATESVILLE, NC 28677

LOCATION I-40 W, TL OLD MOUNTAIN ROAD, TR CELESTE EUFOLA ROAD, ON LEFT AT LANAS END DR.

SUBDIVISION BLOCK / SECTION LOT LOT AREA 5.17 ACRES SITE CLASS. PS DESIGN FLOW 240 L.T.A.R. 0.30 GPD/FT²

Septic Tank: 1000 Gallons; STB Date 2-2-98

Pump Tank: Gallons; PT Date

Pump Make: Model Serial No.

Nitrification Field: No Fields 1 Square Feet 810 Linear Feet 270

No Lines THREE Trench Width 36" Max Trench Bottom Depth 36" Gravel Depth 12"

☑ New System ☐ Repair System Type: I, II, III, IV, V, VI

System Description: CONVENTIONAL GRAVITY

Repair System Description: CONV. GRAVITY

Maintenance Agreement Required: ☐ Yes ☑ No

☑ House/Mod. Home ☐ Mobile Home ☐ Business ☐ Other

No. Bedrooms 2 No. Bathrooms 2 No. Employees


☐ Slab ☑ Crawl Space ☐ Basement w/plumbing ☐ Basement wo/plumbing

Water Supply: ☐ Individual ☑ Public ☑ Community

Comments:/Conditions:

Comments:/Conditions:

SCALE: 1" = 40' INITIAL SITE SKETCH REPAIR

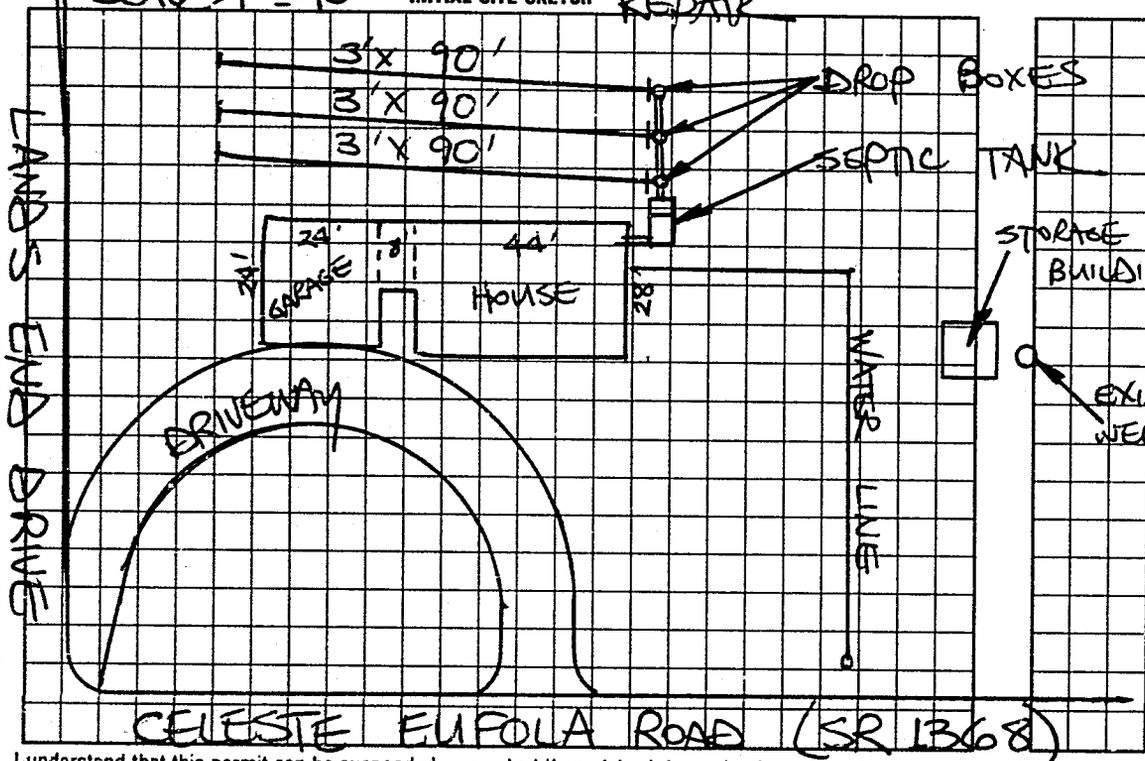

AS BUILT SKETCH

Installed as shown

I understand that this permit can be suspended or revoked if any false information is supplied toward securing the permit/any unauthorized changes are made to the site/any unauthorized changes are made in the installation of the system. Improvement Permit with plat valid without expiration. Improvement Permit with site plan valid for sixty months. Authorization to Construct is valid for a period equal to that of Improvement Permit – not to exceed sixty months.

Signed: X James S Hartness date 1-15-98 Installed by: Forest Shuffard

Improvement Permit by: STEVE HEDRICK date 1-15-98 Operation Permit by: Mark C. Oaks RS date 4-13-98

Authorization to Construct by: STEVE HEDRICK date 1-15-98 Existing System Inspection by: date

HEALTH DEPT. COPY: WHITE INSPECTION COPY (FINAL): GREEN OWNER COPY (FINAL): YELLOW INSPECTION COPY (INITIAL): PINK OWNER COPY (INITIAL): GOLD

9 2 8 1 0 0