IREDELL COUNTY HEALTH DEPARTMENT

IMPROVEMENT PERMIT / CERTIFICATE OF COMPLETION / OPERATION PERMIT / EXISTING SYSTEM INSPECTION

STATESVILLE 704-878-5305 MOORESVILLE 704-664-5281

✓ 44629

PROPERTY DESCRIPTION NO. 15099 DATE 9-17-93

OWNER OR CONTRACTOR Blake Reep Jr. PHONE: Business _____ Home _____

ADDRESS _____

LOCATION I40W TL Old Mtn Rd TR Celeste-Eufola Rd lot on R just past Rosebud Lane TAX MAP NO. 8J-8-A-13

SUBDIVISION Sadie Rosemon Prop. BLOCK / SECTION _____ LOT 13 LOT AREA 1.35 acres SITE CLASS. P.S. L.T.A.R. .4 gpd/ft²

Water Supply: ☐ Individual ☐ Community ☑ Public County water

Septic Tank: 1000 Gallons: STB 1012 Date 6-21-93

Pump Tank: — Gallons: PT — Date —

Nitrification Field: No Fields 1 Square Feet 1080 Linear Feet 360'

No Lines 4 Trench Width 36" Trench Depth 18"-36" Gravel Depth 12"

☑ New System ☐ Repair System Type: I. (II.) III. IV. V. VI

System Description: Conventional, gravity

Repair System Description: " "

Maintenance Agreement Required: ☐ Yes ☑ No

☑ House/Mod. Home ☐ Mobile Home ☐ Business ☐ Other _____

No. Bedrooms 3 No. Bathrooms 2.5 No. Employees _____

☐ Slab ☑ Crawl Space ☐ Basement w/plumbing ☐ Basement wo/plumbing

Garbage Disposal: ☐ Yes ☑ No

Auto. Dishwasher: ☐ Yes ☐ No


Auto. Washing Machine: ☑ Yes ☐ No

Other _____

Comments System left open to rain. This may affect life span of septic system. 100% Repair Area behind house, conventional, gravity fed.

INITIAL SITE SKETCH

AS BUILT SKETCH

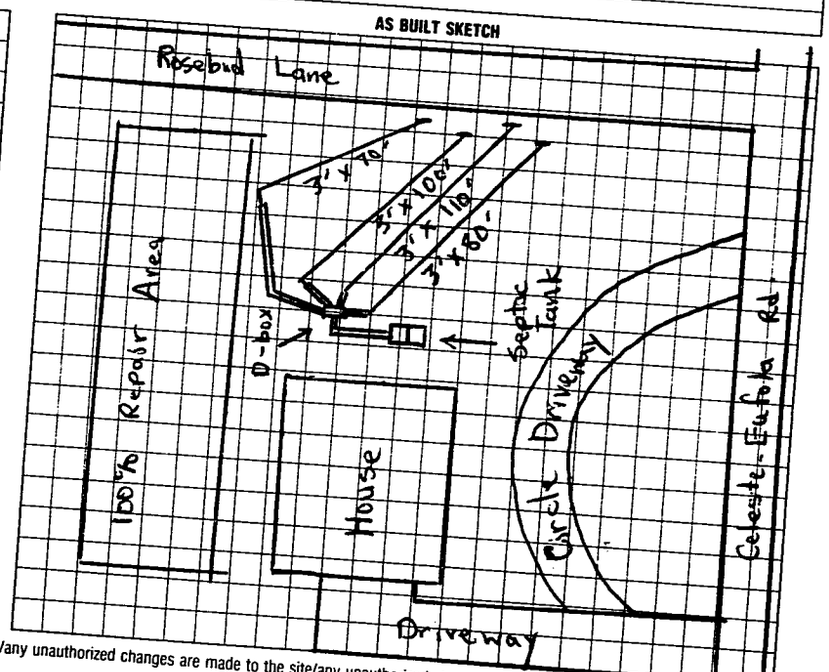

I understand that this permit can be suspended or revoked if any false information is supplied toward securing the permit/any unauthorized changes are made to the site/any unauthorized changes are made in the installation of the system. Improvement Permit is valid for 60 months from date of issuance.

Signed: _____

Improvement Permit by: Steve Brown date 9-2-92

Existing System Inspection by: _____ date _____

Installed by: Harry Reep

Certificate of Completion by: Michael J Dennis date 9-17-93

Operation Permit by: _____ date _____

HEALTH DEPT. COPY: WHITE INSPECTION COPY (FINAL): GREEN OWNER COPY (FINAL): YELLOW INSPECTION COPY (INITIAL): PINK OWNER COPY (INITIAL): GOLD