4:00

IREDELL COUNTY HEALTH DEPARTMENT - *ENVIRONMENTAL HEALTH* ☒ STATESVILLE OFFICE 704-878-5305 ☐ MOORESVILLE OFFICE 704-664-5281

IMPROVEMENT PERMIT / AUTHORIZATION TO CONSTRUCT (2) / OPERATION PERMIT (2) / EXISTING SYSTEM INSPECTION

PERMIT # 167563 PIN # 4712-28-3663 DATE 7-26-11

OWNER Morris Roseman APPLICANT: PHONE: Home/Cell # 704 902 2086 Business #

SITE ADDRESS Roseman Ln OWNER / APPLICANT ADDRESS


SITE DIRECTIONS 40W to 5 on Old Mtn, (R) on Celeste Eufola, corner of Celeste Eufola & Rose Bud

SUBDIVISION n/a BLOCK / SECTION n/a LOT # n/a LOT AREA 13.225 DESIGN FLOW 360 L.T.A.R. .25


Septic Tank 1000	Gallons: STB 317	Date 4-7-11	☒ New System	☐ Repair	☐ Expansion System	Type I II (III) IV V VI	☒ Residence	No. Bedrooms 3	Water Supply
Pump Tank	Gallons: P T	Date	System Description: 25% Reduction - Gravity				☐ Business	No. Persons	☒ Private
Pump Make	Model	Serial #	Repair System Description: 25% Reduction - Gravity				☐ Other	No. Employees	☒ Public
No. Nitrification Fields: 1	No. Lines 4	Linear Feet 90 each 3 Wide	Maintenance Agreement Required	☐ YES	☒ NO		☐ Slab	☐ Crawl Space	☐ Community
Trench Width 36"	Max. Trench Bottom Depth 36"	Gravel Depth n/a	☒ GRAVITY	☐ PRESSURE			☐ Basement w/plumbing	☒ Basement w/o plumbing	

Comments / Conditions

INITIAL SITE SKETCH

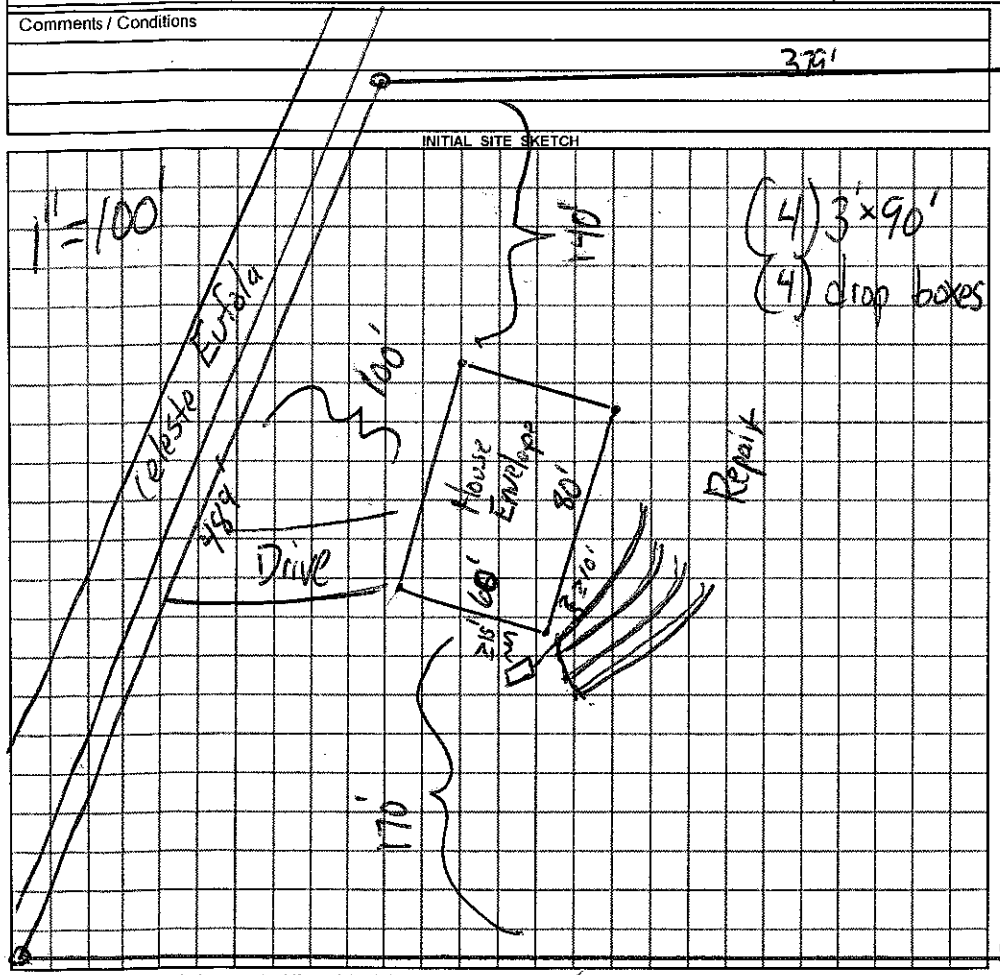

AS BUILT SKETCH

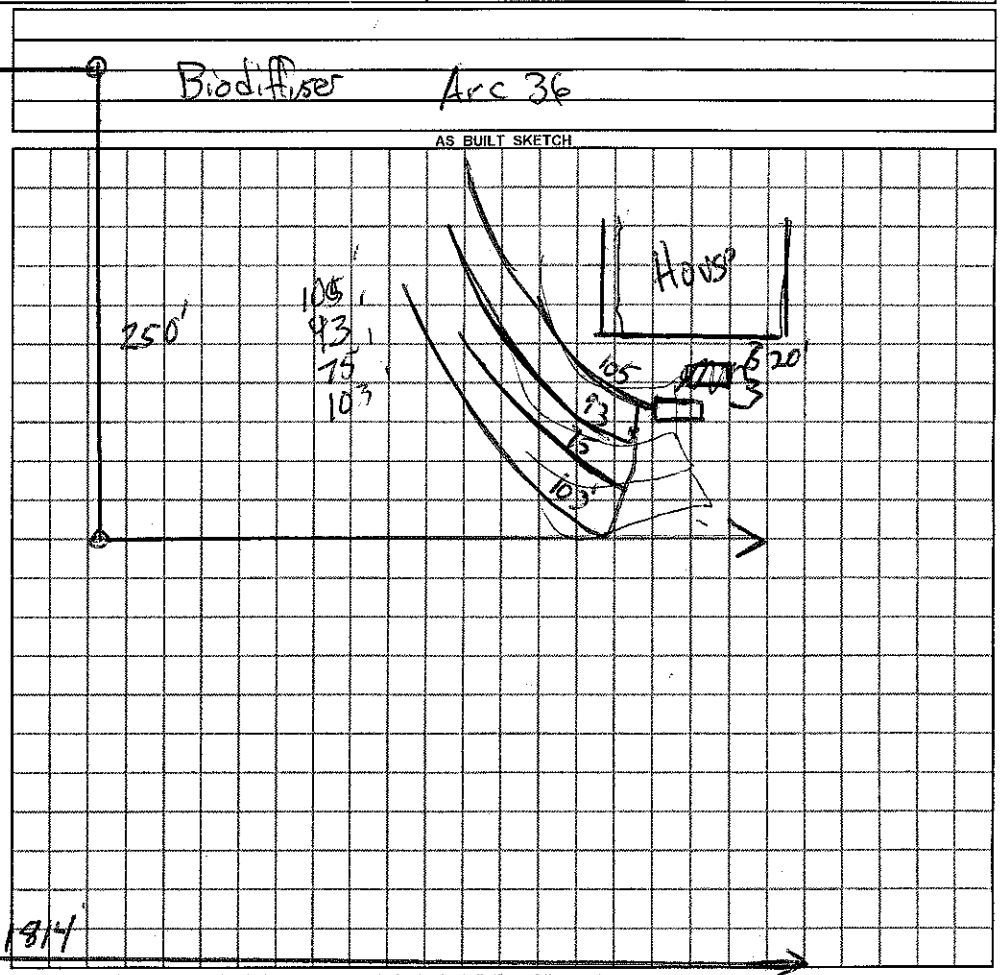

Permit can be suspended or revoked if false information is supplied toward securing the permit / any unauthorized changes are made to the site / any unauthorized changes are made in the installation of the system.

☐ *IMPROVEMENT PERMIT* with plat valid without expiration. ☒ *IMPROVEMENT PERMIT* with plat valid without expiration. site plan valid 60 mo. ☒ *AUTHORIZATION TO CONSTRUCT* valid for period equal to IMPROVEMENT PERMIT--not to exceed 60 mo.

Owner / Applicant Signature: Morris D Roseman Date 8-19-11 Installed by: James Hyatt Hyatt

IMPROVEMENT PERMIT by: James Hyatt REHS Date 7-26-11 OPERATION PERMIT by: James Hyatt REHS Date 4-25-12

AUTHORIZATION TO CONSTRUCT by: James Hyatt REHS Date 7-26-11 Existing System Inspected by: REHS Date

YOU SHOULD CONTACT A LOCATOR SERVICE PRIOR TO ANY EXCAVATION

White Copy – Environmental Health YELLOW COPY (Final) Owner / Applicant PINK COPY (Initial) Owner / Applicant