IREDELL COUNTY HEALTH DEPARTMENT

Statesville Office (704) 878-5305 Mooresville Office (704) 660-3625 PERMIT # 211765

IMPROVEMENT PERMIT / AUTHORIZATION TO CONSTRUCT / OPERATION PERMIT / EXISTING SYSTEM

PIN # 4712-34-0814

APPLICANT: Wendy Deane APPLICANT ADDRESS: 1465 Buffalo Shoals Rd Statesville NC

SITE ADDRESS: 217 Atwell Dr Statesville NC PHONE: 704-239-3643 ALT. PHONE: N/A

SITE DIRECTIONS: (R) on 6 Baynal (L) Buffalo Shoals (R) Futola (R) Atwell Property on left

SUBDIVISION: Futola Farms SECTION: N/A LOT # 25 LOT AREA: 1.376ac DESIGN FLOW: 360 L.T.A.R.: 6.25

Septic Tank 1000 (gal) STB 760-1000 Date 7-17
Pump Tank (gal) PT Date
Pump Make Model Serial #
Nitrification Fields 1 # Lines 3 Linear Ft: 360
Trench Width 36" Max. Trench Bottom Depth 30" Gravel Depth N/A


[X] New System [ ] Repair [ ] Expansion System Type: I II [III] IV V VI
System Description: 25% reduction
Repair System Description: 50% reduction
Maintenance Agreement Required: [ ] YES [X] NO
[X] GRAVITY [ ] PRESSURE

[X] Residence No. Bedrooms 3
[ ] Business No. Persons 6
[ ] Other No. Employees
[ ] Slab [X] Crawl Space
[ ] Basement w/plumbing [ ] Basement w/o plumbing


Water Supply: [X] Private [ ] Public [ ] Community

Comments / Conditions: Install 25% reduction on contour with serial distribution

INITIAL SITE SKETCH

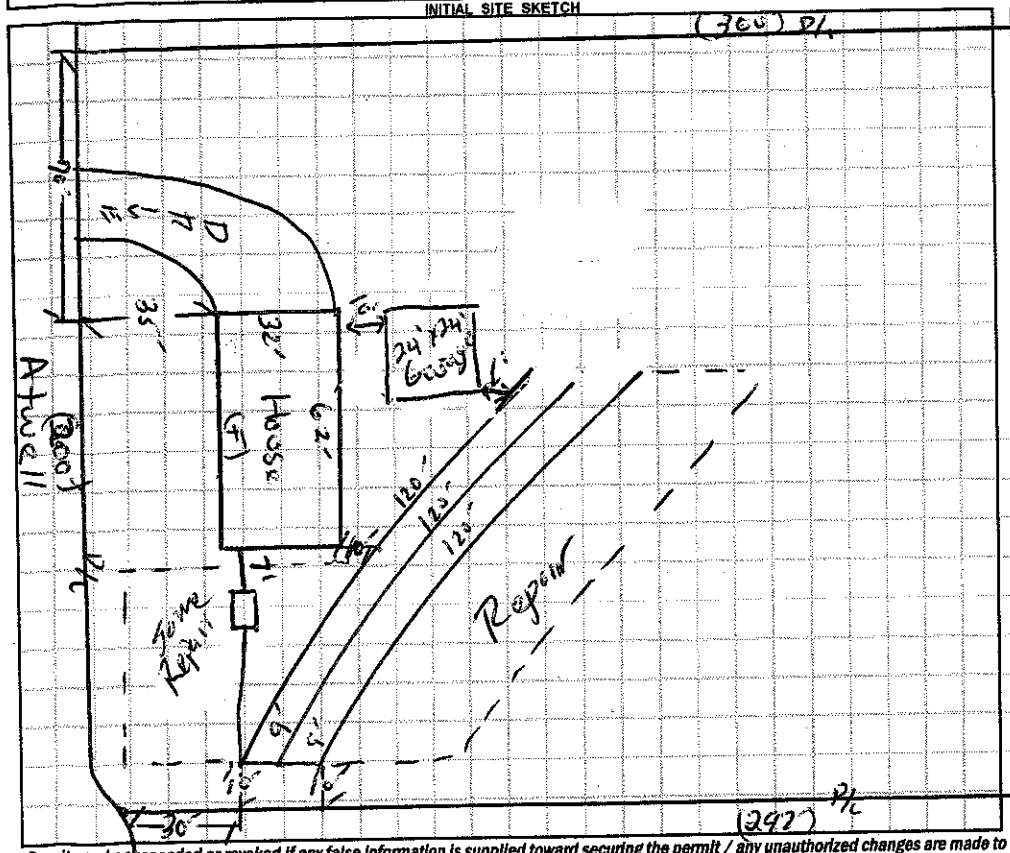

AS BUILT SKETCH

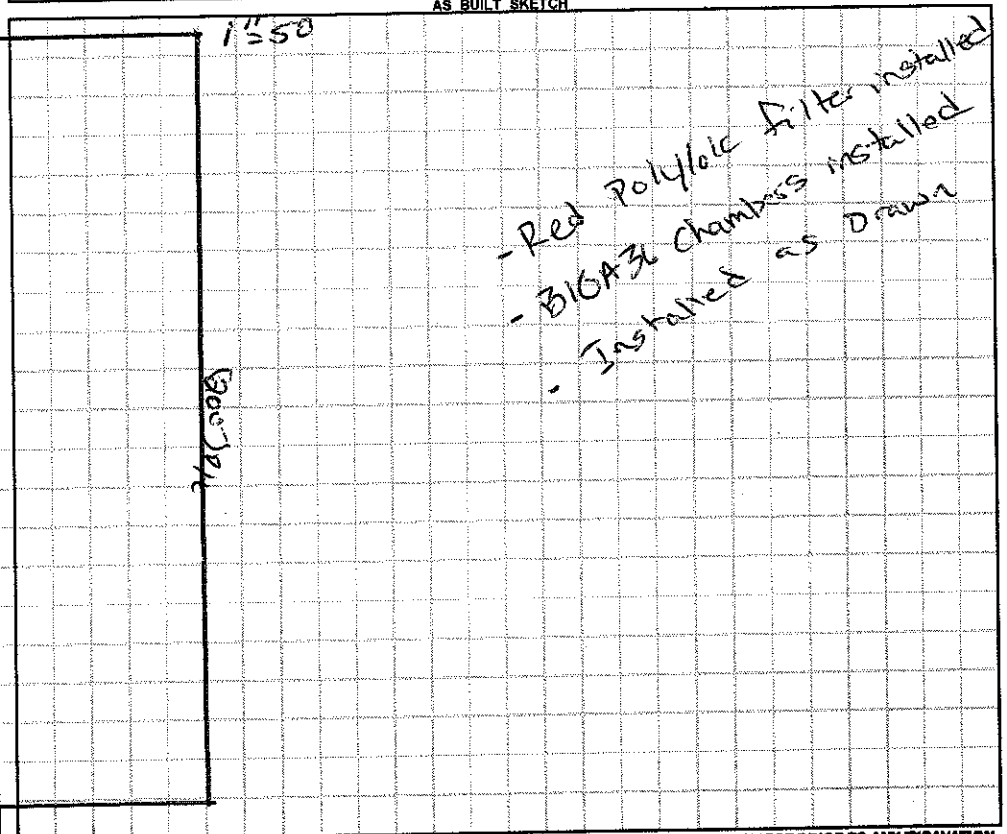

Permit can be suspended or revoked if any false information is supplied toward securing the permit / any unauthorized changes are made to the site / any unauthorized changes are made in the installation of the system. **CONTACT A LOCATOR SERVICE PRIOR TO ANY EXCAVATION**

[ ] **IMPROVEMENT PERMIT** *with plat valid without expiration.* [X] **IMPROVEMENT PERMIT** *with site plan valid for 60 mos.* [X] **AUTHORIZATION TO CONSTRUCT** *valid for period equal to IMPROVEMENT PERMIT--not to exceed 60 mo.*

Owner / Applicant Signature: Wendy Deane Date: 10/16/15 Installed by: Tim Abee

IMPROVEMENT PERMIT by: David Hyatt Date: 10/16/15 OPERATION PERMIT by: Justin Henderson Date: 10-20-15

AUTHORIZATION TO CONSTRUCT by: David Hyatt Date: 10/16/15 Existing System Inspected by: Date:

Health Dept. Copy - WHITE Applicant (Final Approval) - YELLOW Applicant (Conditional Approval) - PINK