Contact Customer TO meet At location TRAVIS

Call day before

IREDELL COUNTY HEALTH DEPARTMENT

540-257-1016


ENVIRONMENTAL HEALTH DIVISION

PAGE 2: *SITE PLAN WORKSHEET*

SEE THE "SAMPLE SITE PLAN" BELOW. *INCOMPLETE SITE PLANS WILL BE RETURNED TO YOU FOR COMPLETION AND MAY RESULT IN A DELAY IN THE ISSUANCE OF YOUR SEPTIC SYSTEM PERMIT!!!*

Place an (X) beside each item as you complete the site plan:

- X Property Line measurements are clearly identified
- X All proposed structures are indicated
- X Front and side setbacks from property line
- X Preferred driveway location and well location
- X Area you prefer your septic system to be placed
- X North arrow, or other sufficient indicator of direction

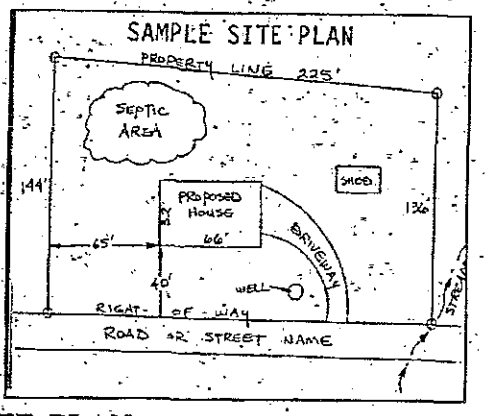

Circle N/A on the following if appropriate:

Location of septic systems and wells within 100' of your property N/A
Location of easements and rights of ways on your property N/A
Location of any designated wetlands on the property N/A

USE THIS SPACE TO DRAW YOUR SITE PLAN

Show: proposed house or business footprint, wells, water lines, patios, pools and decks, and any other item that will occupy space on the site

SEE Attached Sheet.

Signature: Travis Vaughn

Property owner or owner's legal representative signature (SIGNATURE REQUIRED)

9/15/14

DATE

CI

6 x 60' LINES

IREDELL COUNTY HEALTH DEPARTMENT

STATESVILLE 704-878-5305 MOORESVILLE 704-664-5281

IMPROVEMENT PERMIT / AUTHORIZATION TO CONSTRUCT / OPERATION PERMIT / EXISTING SYSTEM INSPECTION

PERMIT# 128549 PIN# 4712-34-9644-000 STS#

OWNER OR APPLICANT JERRY PATE DATE 10/25/06

ADDRESS 239 LOWE [illegible] STATESVILLE NC 28677 PHONE Business 704-878-1855 Home 704-878-0556

LOCATION SUTTLE SHORES (E. CORNER OF) ATWELL (E. TURNPIKE) Property on LEFT

SUBDIVISION LOT# [illegible] BLOCK SECTION LOT 49 ACRES 2.715 FLOOD ZONE X SOILS 25

Septic Tank 1000 Gal. Pump Tank Gal. Pump Make Pump Model Alarm Yes Float Switch Yes Effluent Filter Yes Manhole Cover Yes Distribution Box Yes Gravity Pressure

New System Repair Expansion System Type Conventional Other

Repair System Description SAME

Existing System Information Unknown

House/Mod Home Mobile Home Business Other

No. Bedrooms 3 No. Persons 6 No. Employees

Water Supply Individual Public Community


Soil Classification Type Loading Rate Trench Bottom Depth 36 Trench Width 24 Trench Length 60 Number of Trenches 6 Total Linear Feet 360

Installation Stone Aggregate Pressure Slab Crawl Space Basement & plumbing Basement w/ pump/tank


6 TRENCH 6 LINES / 60' LONG / USE 6 INSPECTION BOXES & 1 DISTRIBUTION BOX / ATWELL DRIVE CUTS AT 36" DEEP

TYPE III F. Hu. MODIFIED INSTALL 5 HOUSE CAT PUMP SYSTEM LINES 30' OUT OF PL

NOT TO SCALE N.T.A. SITE SKETCH

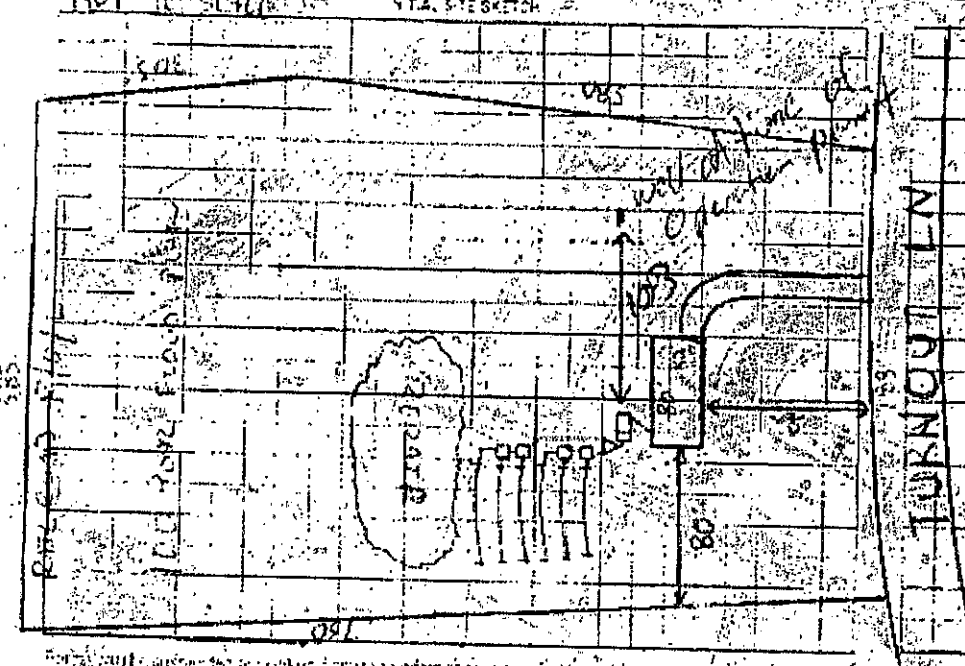

AS BUILT SKETCH

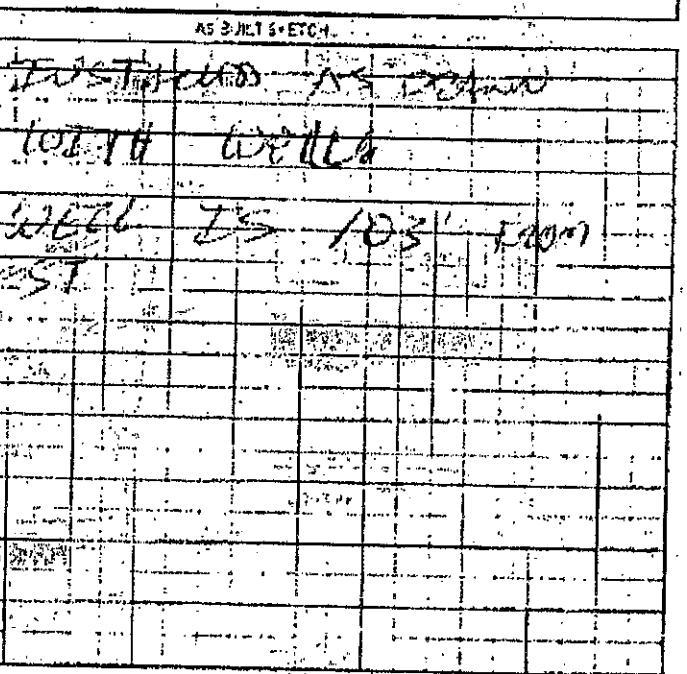

Improvement Permit valid for sixty months. Authorization to Construct valid for a period equal to the Improvement Permit - not to exceed sixty months.

Signature [illegible] Date 10-27-06 Operation Permit Date 11-27-06

Existing System Inspection by [illegible] Date 6-27-07

WHITE COPY - APPLICANT CANARY YELLOW - OWNER'S FINAL PINK