IREDELL COUNTY HEALTH DEPARTMENT

STATESVILLE 704-878-5305 MOORESVILLE 704-664-5281

IMPROVEMENT PERMIT / AUTHORIZATION TO CONSTRUCT / OPERATION PERMIT / EXISTING SYSTEM INSPECTION

PERMIT# 150595 PIN# 4712430302 DATE 7/29/08

OWNER OR APPLICANT ALL SEASON'S CONTRACTING INC PHONE: Business 704-902-3194 Home

ADDRESS PO BOX 7227 Statesville NC 28677

LOCATION BUFFALO SHOALS SOUTH @ EUFOLA R GO ATWELL 1ST ON LEFT

SUBDIVISION EUFOLA FARMS BLOCK / SECTION — LOT 35 LOT AREA 1.393 SITE CLASS PS DESIGN FLOW 360 L.T.A.R. .13

Septic Tank: 1000 Gallons: STB 1007 Date 12-15-09
Pump Tank: Gallons: PT Date
Pump Make: Model Serial No.
Nitrification Field: No Fields 1 Square Feet EF=1200' Linear Feet 300'
No Lines 6x50' Trench Width 36" Max Trench Bottom Depth 28"

☒ New System ☐ Repair ☐ Expansion System Type: I II III IV V VI
System Description: GRAVITY 25% REDUCT
Repair System Description: LP 50% REDUCT
Maintenance Agreement Required: ☐ Yes ☒ No
Gravel Depth N/A ☒ Gravity ☐ Pressure ☐ Slab ☒ Crawl Space ☐ Basement w/plumbing ☐ Basement wo/plumbing


☒ House/Mod. Home No. Bedrooms 3
☐ Mobile Home No. Persons 6
☐ Business No. Employees
☐ Other

Water Supply: ☐ Individual ☒ Public ☐ Community

Comments/Conditions: ① Note MAXIMUM TRENCH BOTTOM DEPTH ② Install Lines ON CONTOURS & MAINTAIN SETBACKS ③ Install 6 LINES 50' LONG WITH 1 FLOW DIVERTER TEE & 4


INITIAL SITE SKETCH

NOT TO SCALE!!

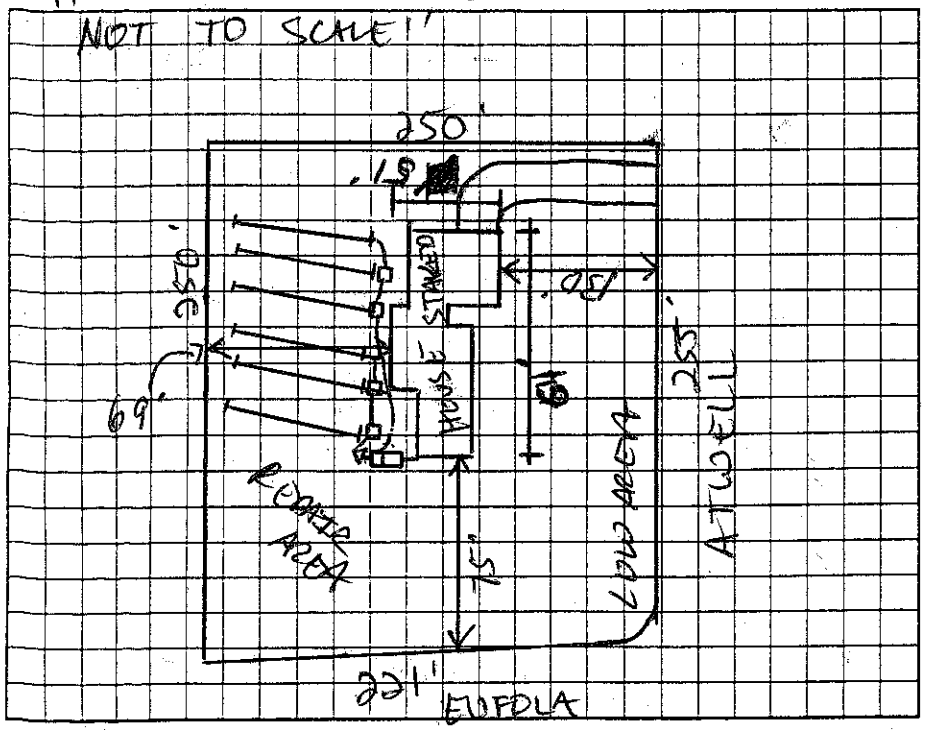

Comments/Conditions: DROP BOXES AS DRAWN @ Kimp System 10' off property line and 5' off house and porch. @ Home IS 64' WIDE & 51' DEEP & ALL Indications were staked by the lot Red Filter Inspector

AS BUILT SKETCH

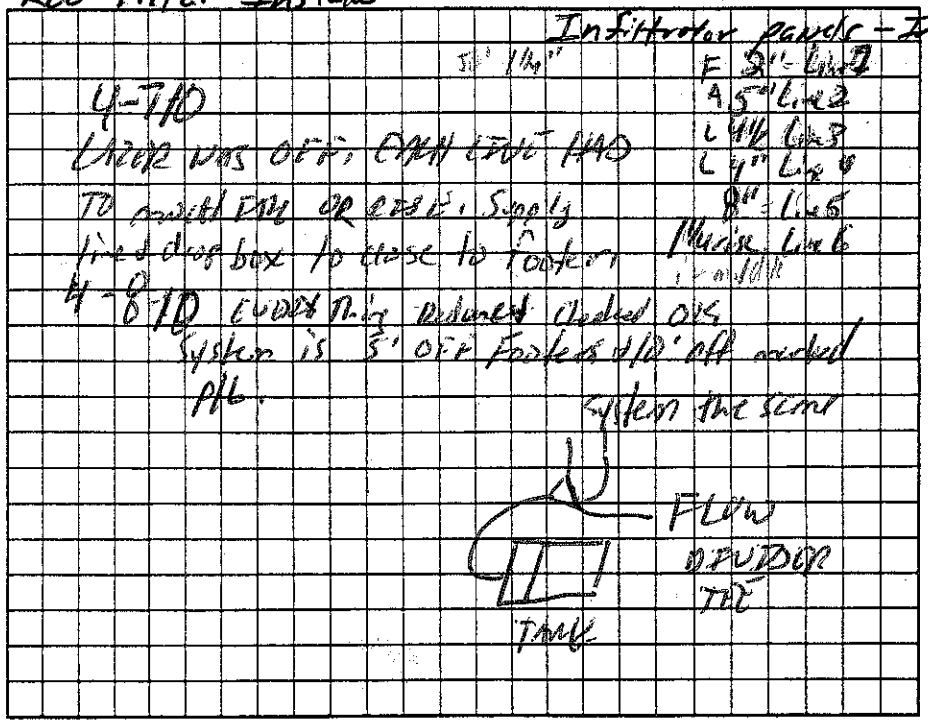

Permit can be suspended or revoked if any false information is supplied toward securing the permit/any unauthorized changes are made to the site/any unauthorized changes are made in the installation of the system. Improvement Permit with plat valid without expiration ☐ Improvement Permit with site plan valid for sixty months ☒ Authorization to Construct is valid for a period equal to that of Improvement Permit – not to exceed sixty months.

Signed: Sandra Myers date 7/31/08

Improvement Permit by: date 7/29/08

Authorization to Construct by: date 7/29/08

Installed by: JAMES WOODIE

Operation Permit by: date 4-8-10

Existing System Inspection by: date

HEALTH DEPT. COPY: WHITE OWNER COPY (FINAL): YELLOW OWNER COPY (INITIAL): PINK