IREDELL COUNTY HEALTH DEPARTMENT

STATESVILLE 704-878-5305 MOORESVILLE 704-664-5281

IMPROVEMENT PERMIT / AUTHORIZATION TO CONSTRUCT / OPERATION PERMIT / EXISTING SYSTEM INSPECTION

CI

PERMIT# 137374 PIN# 4712-34-9614 DATE 8-15-06

OWNER OR APPLICANT JERRY Price PHONE: Business 704-902-4355 Home

ADDRESS 239 LEWIS FERRY RD STATESVILLE NC 28677

LOCATION BUFFALO SHOALS @ EUFOLA @ ATHELL LOT # 7 ON RT

SUBDIVISION EUFOLA FARMS BLOCK / SECTION LOT 7 LOT AREA 11326 SITE CLASS. 95 DESIGN FLOW 360 L.T.A.R. 13

Septic Tank: 1000 Gallons; STB 1012 Date 2-27-07

Pump Tank: Gallons; PT Date

Pump Make: Model Serial No.

Nitrification Field: No Fields 1 Square Feet EQ=1760 Linear Feet 300'

No Lines 4x75 Trench Width 36" Max Trench Bottom Depth 36" Gravel Depth N/A

☒ New System ☐ Repair ☐ Expansion System Type: I II III IV V VI

System Description: 60 WIDTH 25% REDUCT

Repair System Description: LP 25% REDUCT

Maintenance Agreement Required: ☐ Yes ☒ No

☒ House/Mod. Home ☐ Mobile Home ☐ Business ☐ Other

No. Bedrooms 3 No. Persons 6 No. Employees


Water Supply: ☐ Individual ☒ Public ☐ Community

☒ Gravity ☐ Pressure ☐ Slab ☒ Crawl Space ☐ Basement w/plumbing ☐ Basement wo/plumbing

Comments:/Conditions: ① SYSTEM SHOT IN AND FLAGGED ② CALL Prior to installation FOR FLYBOY ③ MAINTAIN SETBACKS ④ INSTALL LINES ON CONTOUR AND MAINTAIN SETBACKS

Comments:/Conditions: TOFFITE Filters + PUMP System 40' OFF MAILBOX P/L, NO Driveway placed at front of church

NOT TO SCALE INITIAL SITE SKETCH

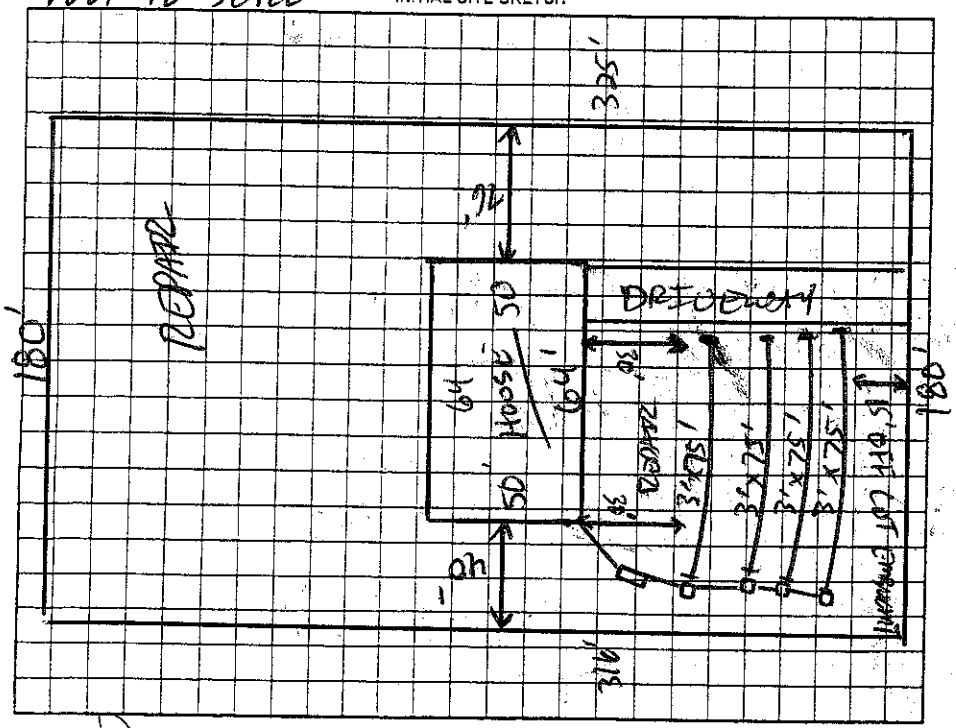

AS BUILT SKETCH

Permit can be suspended or revoked if any false information is supplied toward securing the permit/any unauthorized changes are made to the site/any unauthorized changes are made in the installation of the system. Improvement Permit with plat valid without expiration ☐ Improvement Permit with site plan valid for sixty months ☒ Authorization to Construct is valid for a period equal to that of Improvement Permit – not to exceed sixty months.

Signed: date 8-15-06

Improvement Permit by: date 8-15-06

Authorization to Construct by: date 8-15-06

Installed by: DALE WINDLER

Operation Permit by: date 8-3-07

Existing System Inspection by: date

HEALTH DEPT. COPY: WHITE OWNER COPY (FINAL): YELLOW OWNER COPY (INITIAL): PINK