IREDELL COUNTY HEALTH DEPARTMENT

STATESVILLE 704-878-5305 MOORESVILLE 704-664-5281

IMPROVEMENT PERMIT / AUTHORIZATION TO CONSTRUCT / OPERATION PERMIT / EXISTING SYSTEM INSPECTION

PERMIT# 140760 PIN# 4712443044 67

OWNER OR APPLICANT MATHEW MORRIS PHONE: Business 704-883-5799 704-929-6498 DATE 4-4-07

ADDRESS 129 CHATFIELD LOOP MC 28677 Home 704-873-2101

LOCATION BUFFALO SHOALS RD ⓑ EUFOLA ⓒ ATWELL ⓓ LOT # 8

SUBDIVISION EUFOLA FARMS BLOCK / SECTION LOT 8 LOT AREA 1.512 SITE CLASS PS DESIGN FLOW 360 L.T.A.R. .3

Septic Tank: 1000 Gallons; STB 760 Date 3-20-07 ☒ New System ☐ Repair ☐ Expansion System Type: I II III IV V VI

Pump Tank: Gallons; PT Date System Description: GRAVITY 25% REDUCTION

Pump Make: Model Date Repair System Description: LOW PRESS 25% REDUCTION

Nitrification Field: No Fields 1 Square Feet EQ=1200' Serial No. Maintenance Agreement Required: ☐ Yes ☒ No

No Lines 3 X 100' Trench Width 36" Linear Feet 300' Gravel Depth N/A ☒ Gravity ☐ Pressure

Max Trench Bottom Depth 36"


☒ House/Mod. Home No. Bedrooms 3 ☐ Mobile Home No. Persons 6 ☐ Business No. Employees ☐ Other ☐ Slab ☒ Crawl Space ☐ Basement w/plumbing ☐ Basement wo/plumbing

Water Supply: ☐ Individual ☒ Public ☐ Community

Comments/Conditions: ① FILL & PACK WASH OUT. KEEP SYSTEM 5' OFF WASHOUT AFTER THIS IS DONE ② KEEP SYSTEM 15' OFF 2' CUT EMBANKMENT ③ HOUSE STAKING HAD TO BE SLID BACK TO ALLOW SEPTIC IN FRONT YARD. MET ONNOR & SHOWED NOT TO SCALE

Comments/Conditions: ① Him the new house placement criteria ② KEEP GARAGE SUPPLY SEPERATE FROM HOUSE SUPPLY LINE. ③ DURING BUILDING THE HOUSE & DETACHED GARAGE, MAKE SURE PROPER INFO IS KEPT FROM SUPPLY OUTLETS TO THE TANK.

INITIAL SITE SKETCH

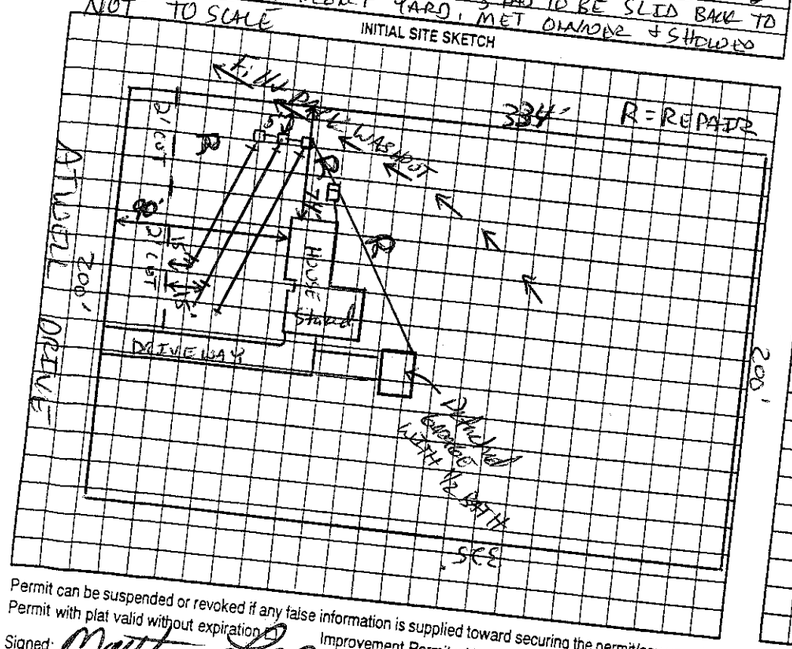

AS BUILT SKETCH

Red Schedule 40 PolyPipe Septic Marker

Permit can be suspended or revoked if any false information is supplied toward securing the permit/any unauthorized changes are made to the site/any unauthorized changes are made in the installation of the system. Improvement Permit with plat valid without expiration ☐ Improvement Permit with site plan valid for sixty months ☒ Authorization to Construct is valid for a period equal to that of Improvement Permit – not to exceed sixty months.

Signed: Matthew L Morris

Improvement Permit by: date 4-4-07

Authorization to Construct by: date 4-4-07

Installed by: Jenny Madison

Operation Permit by: date 4-4-07

Existing System Inspection by: date 1-9-08

date

HEALTH DEPT. COPY: WHITE OWNER COPY (FINAL): YELLOW OWNER COPY (INITIAL): PINK