EFT# 86329

IREDELL COUNTY HEALTH DEPARTMENT

Statesville Office (704) 878-5305 Mooresville Office (704) 660-3625 PERMIT # 208321

IMPROVEMENT PERMIT / AUTHORIZATION TO CONSTRUCT / OPERATION PERMIT / EXISTING SYSTEM

PIN # 4712449628

APPLICANT: Judy Overcash APPLICANT ADDRESS: 116 Powderhorn Rd Mooresville NC

SITE ADDRESS: 205 Low Ln Statesville NC PHONE: 704-528-3137 ALT. PHONE: 704-239-3693

SITE DIRECTIONS: Buffalo Shoals T/R Eufola T/R low Ln at very end of low Ln

SUBDIVISION: N/A SECTION: N/A LOT # N/A LOT AREA: 10ac DESIGN FLOW: 360 L.T.A.R.: 0.25

Septic Tank 1000 (gal) STB 760 Date 3-27-15
Pump Tank 1000 (gal) PT 363 Date 2-5-15
Pump Make Zoeller Model BN151B Serial #
Nitrification Fields 1 # Lines 4 Linear Ft: 360
Trench Width 36" Max. Trench Bottom Depth 30" Gravel Depth N/A

☒ New System ☐ Repair ☐ Expansion System Type: I II III IV V VI
System Description: 25% Reduction PM
Repair System Description: 25% Reduction PM
Maintenance Agreement Required: ☐ YES ☒ NO
☐ GRAVITY ☒ PRESSURE

☒ Residence ☐ Business ☐ Other ☐ Slab ☐ Basement w/plumbing
No. Bedrooms 3 No. Persons 6 No. Employees
☒ Crawl Space ☐ Basement w/o plumbing

Water Supply: ☒ Private ☐ Public ☐ Community

Comments / Conditions: See Plan by S+ME

INITIAL SITE SKETCH

Install Per Plan by S+ME

AS BUILT SKETCH

	Date	Initials
Drain Lines Checked	06/08/15	HS
Tanks Checked	06/08/15	HS
Pressure Manifold or Valve Box Checked	06/08/15	HS
Pressure Head Set	06/08/15	HS
Electrical Checked		
Floats Set	06/08/15	HS
Alarm Checked		N/A
Maintenance Contract Y (N)		

Permit can be suspended or revoked if any false information is supplied toward securing the permit / any unauthorized changes are made to the site / any unauthorized changes are made in the installation of the system. **CONTACT A LOCATOR SERVICE PRIOR TO ANY EXCAVATION**

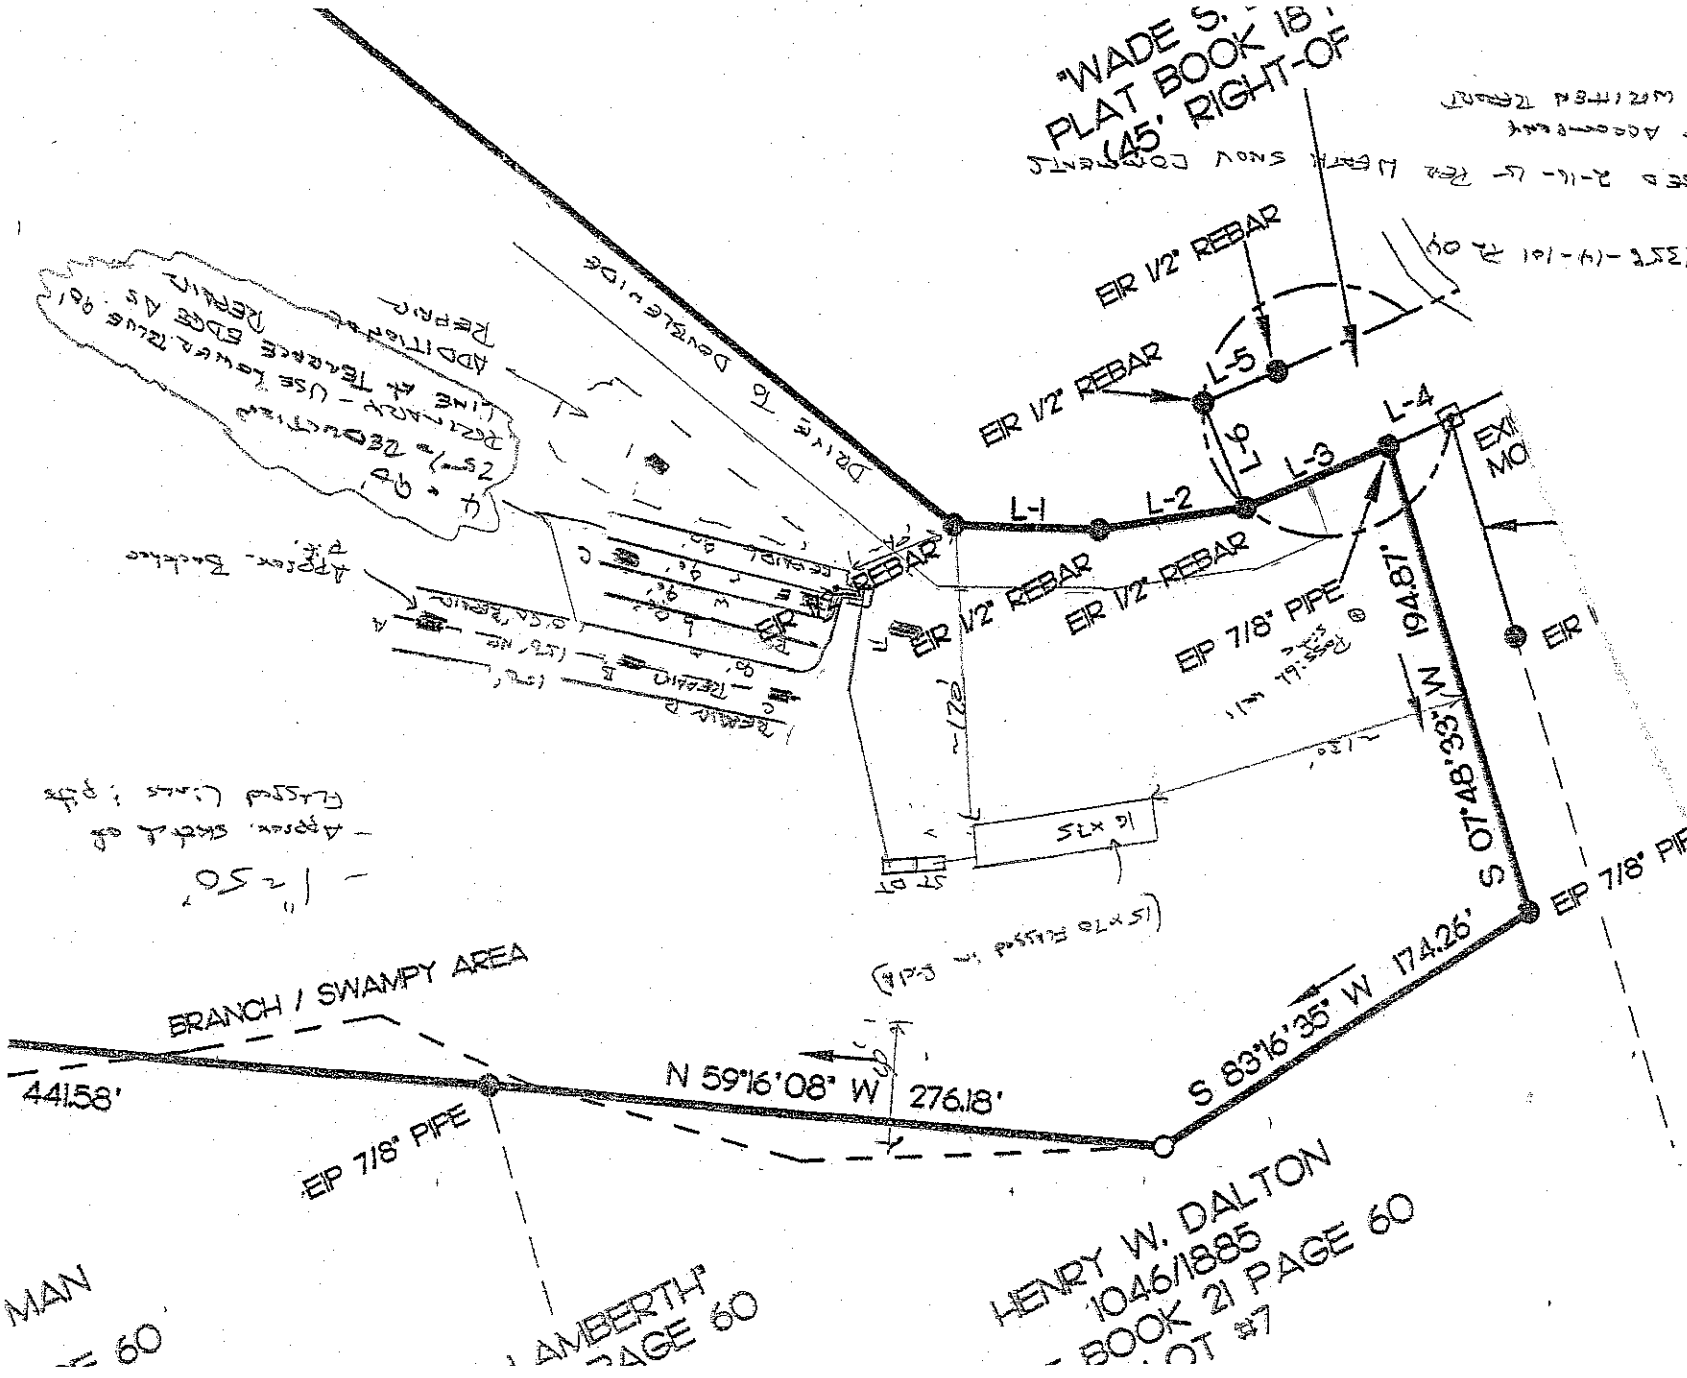
☐ **IMPROVEMENT PERMIT** *with plat valid without expiration.* ☒ **IMPROVEMENT PERMIT** *with site plan valid for 60 mos.* ☑ **AUTHORIZATION TO CONSTRUCT** *valid for period equal to IMPROVEMENT PERMIT--not to exceed 60 mo.*

Owner / Applicant Signature: Judy Overcash Date: 2/27/15 Installed by: Abees Clearing & Grading

IMPROVEMENT PERMIT by: David A Lynn Date: 02/23/15 OPERATION PERMIT by: David A Lynn Date: 07/23/15

AUTHORIZATION TO CONSTRUCT by: David A Lynn Date: 02/23/15 Existing System Inspected by: Date:

Health Dept. Copy - WHITE Applicant (Final Approval) - YELLOW Applicant (Conditional Approval) - PINK


"WADE S. ...
PLAT BOOK 18 ...
45' RIGHT-OF
EIR 1/2" REBAR
EIR 1/2" REBAR
L-5
L-6
L-4
L-3
L-2
L-1
EIR 1/2" REBAR
EIR 1/2" REBAR
EIP 7/8" PIPE
EIR
194.87'
S 07°48'33" W
EIP 7/8" PIP
S 83°16'35" W 174.26'
N 59°16'08" W 276.18'
441.58'
BRANCH / SWAMPY AREA
EIP 7/8" PIPE
HENRY W. DALTON
1046/1885
BOOK 21 PAGE 60
MAN
60
AMBERTH
PAGE 60