IREDELL COUNTY HEALTH DEPARTMENT

STATESVILLE 704-878-5305 MOORESVILLE 704-664-5281

IMPROVEMENT PERMIT / AUTHORIZATION TO CONSTRUCT / OPERATION PERMIT / EXISTING SYSTEM INSPECTION

PERMIT # 150840 PIN # 4712-45-0467 DATE 6-22-09

OWNER or APPLICANT Charles Workman PHONE: Business (704) 878-9786 Home (704) 622-6827

OWNER or APPLICANT ADDRESS 137 Sonita Drive Statesville, NC 28677

LOCATION / DIRECTIONS Buffalo Shoals Rd. Cross Old Mountain Rd R Eufola R Atwell TR / Turn out - Starks 2 story

SUBDIVISION Eufola Farms BLOCK / SECTION 2.441 Ac LOT # 18 LOT AREA DESIGN FLOW 360 gpd L.T.A.R. 0.3 gpd/ft²

Septic Tank	1000	Gallons: STB	1067	Date	3-30-09	☒ New System ☐ Repair ☐ Expansion System Type I II III IV V VI	☒ Residence No. Bedrooms 3
Pump Tank		Gallons: P T		Date		System Description: GRAVITY 25% RDN	☐ Business No. Persons 6
Pump Make		Model		Serial #		Repair System Description: GRAVITY 25% EDN	☐ Other No. Employees
Nitrification Field No Fields	1	No Lines	4	Linear Feet	300 LFT	Maintenance Agreement Required ☐ YES ☐ NO	☐ Slab ☐ Crawl Space
Trench Width	36"	Max. Trench Bottom Depth	36"	Gravel Depth	N/A	☒ GRAVITY ☐ PRESSURE	☒ Basement w/plumbing ☐ Basement w/o plumbing


Water Supply: ☐ Private ☒ Public ☐ Community

Comments / Conditions: poly Lock Effluent Filter

Comments / Conditions

INITIAL SITE SKETCH

AS BUILT SKETCH

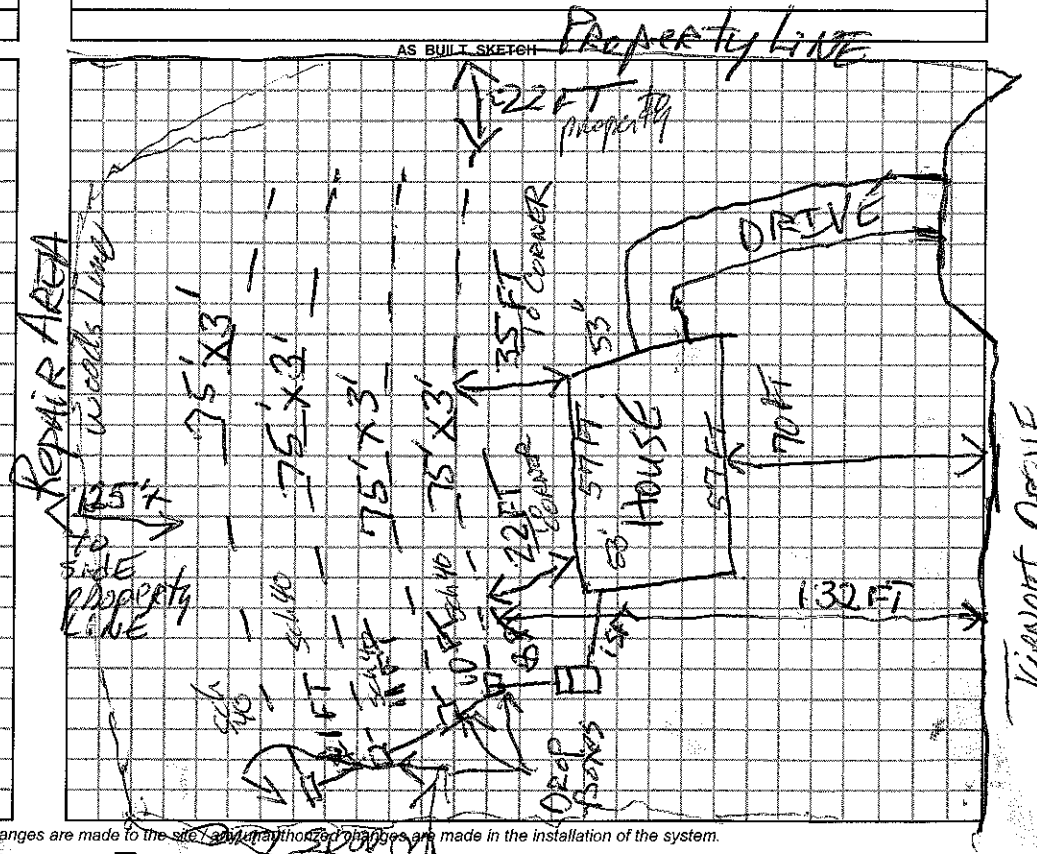

Permit can be suspended or revoked if any false information is supplied toward securing the permit / any unauthorized changes are made to the site / any unauthorized changes are made in the installation of the system.

☐ *IMPROVEMENT PERMIT w / plat valid without expiration.* ☐ *IMPROVEMENT PERMIT w / site plan valid for 60 mos.* ☐ *AUTHORIZATION TO CONSTRUCT valid for period equal to IMPROVEMENT PERMIT-not to exceed 60 mo.*

Owner / Applicant Signature: _____ Date _____

Improvement Permit by: _____ Date _____

Authorization to Construct by: _____ Date _____

YOU SHOULD CONTACT A LOCATOR SERVICE PRIOR TO ANY EXCAVATION.

Installed by: Kelly Osborne #1891

Operation Permit by: Laden Cook RS Date:

Existing System Inspected by: Fred Clemmer / Dre Uy RS Date: 6-22-09

WHITE COPY Environmental Health YELLOW COPY (Final) Owner / Applicant PINK COPY (Initial) Owner / Applicant