Thomas + Antoinette Briggs (C1)

IREDELL COUNTY HEALTH DEPARTMENT

STATESVILLE 704-878-5305 MOORESVILLE 704-664-5281

IMPROVEMENT PERMIT / AUTHORIZATION TO CONSTRUCT / OPERATION PERMIT / EXISTING SYSTEM INSPECTION

PERMIT # 152884 PIN# 4712453242 DATE 10-29-08

OWNER OR APPLICANT (JERRY PRILE Blake) Thomas + Antoinette Briggs PHONE: Business 878-0330 Home

ADDRESS 239 LEWIS FERRY Rd Statesville NC 28677

LOCATION BUFFALO SHOALS (R) EUFOLA (R) ATWELL (R) TURNOUT AT END IN WL-OE-SAR

SUBDIVISION Eufola Farms BLOCK / SECTION LOT 16 LOT AREA 2.157 SITE CLASS. PS DESIGN FLOW 360 L.T.A.R. 1.3

Septic Tank: 1000 Gallons; STB 1012 Date 4-28-08
Pump Tank: Gallons; PT Date
Pump Make: Model Serial No.
Nitrification Field: No Fields 1 Square Feet EB=1200' Linear Feet 300'
No Lines 3 x 100 Trench Width 36" Max Trench Bottom Depth 36" Gravel Depth ~14

☒ New System ☐ Repair ☐ Expansion System Type: I (II) III IV V VI
System Description: GRAVITY 25% REDUCTION
Repair System Description: GRAVITY BUMP 25% REDUCTION
Maintenance Agreement Required: ☐ Yes ☒ No

☒ Gravity ☐ Pressure ☐ Slab ☒ Crawl Space ☐ Basement w/plumbing ☐ Basement wo/plumbing


☒ House/Mod. Home ☐ Mobile Home ☐ Business ☐ Other
No. Bedrooms 3 No. Persons No. Employees

Water Supply: ☐ Individual ☒ Public ☐ Community

Comments:/Conditions: (1) Install Lines on Contours & maintain setbacks (2) Keep paper fill to tank & drainlines from stubout. (3) System is flagged & house is staked. (4) Use 3 Drop Boxes

Comments:/Conditions: (5) Met Pool Contractor & 14'x30' POOL WILL NOT ENCROACH ON Septic & Repair of System. Site PLAN IS ATTACHED. LL 2-11-09 (6) MET BUILDER 3-27-09 & 10x16 BUILDING WILL NOT ENCROACH on Septic & Repair System LL

INITIAL SITE SKETCH

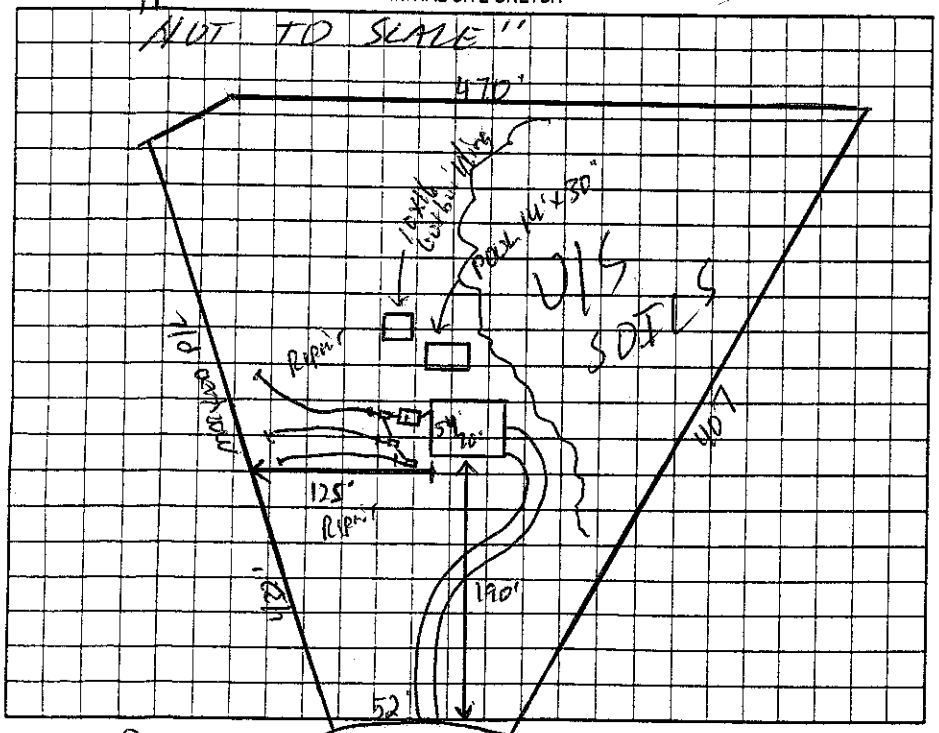

AS BUILT SKETCH

1000 GAL TANK INSTALLED W/ RED POLYLOK FILTER & TANK MARKER

ALSO INSTALLED

- ENDCAP DISTRIBUTION

Permit can be suspended or revoked if any false information is supplied toward securing the permit/any unauthorized changes are made to the site/any unauthorized changes are made in the installation of the system. Improvement Permit with plat valid without expiration ☐ Improvement Permit with site plan valid for sixty months ☒ Authorization to Construct is valid for a period equal to that of Improvement Permit – not to exceed sixty months.

Signed: Jerry Prile date 10-29-08 Installed by: Gunter Grading, owner Jerry Prile

Improvement Permit by: [signature] date 10-29-08 Operation Permit by: Kyle Baker, Fred Clodfelter date 3/31/09

Authorization to Construct by: [signature] date 10-29-08 Existing System Inspection by: date

HEALTH DEPT. COPY: WHITE OWNER COPY (FINAL): YELLOW OWNER COPY (INITIAL): PINK