IREDELL COUNTY HEALTH DEPARTMENT

STATESVILLE 704-878-5305 MOORESVILLE 704-664-5281

IMPROVEMENT PERMIT / AUTHORIZATION TO CONSTRUCT / OPERATION PERMIT / EXISTING SYSTEM INSPECTION

PERMIT# 089305 PIN# 4712 52 3108 PT. DATE 5/30/00

OWNER OR CONTRACTOR Danny Lambeth. PHONE: Business 528-0832 Home

ADDRESS 121 Low Ln. Statesville, NC. 28677

LOCATION Buffalo Shoals TR Enfola Rd. TL on Road past Lambeth Ridge

SUBDIVISION No BLOCK / SECTION LOT LOT AREA ~ 5.9 Ac SITE CLASS RS DESIGN FLOW 360 L.T.A.R. .3

Septic Tank: 1000 Gallons; STB 1600 Date 10-14-00
Pump Tank: Gallons; PT Date
Pump Make: Model Serial No.
Nitrification Field: No. Fields 1 Square Feet 1200 Linear Feet 400
No. Lines 3@133'x3' Trench Width 36" Max Trench Bottom Depth 36" Gravel Depth 12"

[X] New System [ ] Repair System Type: I. II. III. IV. V. VI
System Description: Drip-Conventional
Repair System Description: Repair
Maintenance Agreement Required: [ ] Yes [X] No

[X] House/Mod. Home No. Bedrooms 3
[ ] Mobile Home No. Bathrooms 2
[ ] Business No. Employees
[ ] Other
[ ] Slab [ ] Crawl Space [ ] Basement w/plumbing [ ] Basement w/o plumbing


Water Supply: [X] Individual [ ] Public [ ] Community

Comments/Conditions:

WELL 25'

Comments/Conditions: SEPTIC TANK W/ MARKER INSTALLED USING "TUFTITE" FILTER

INITIAL SITE SKETCH

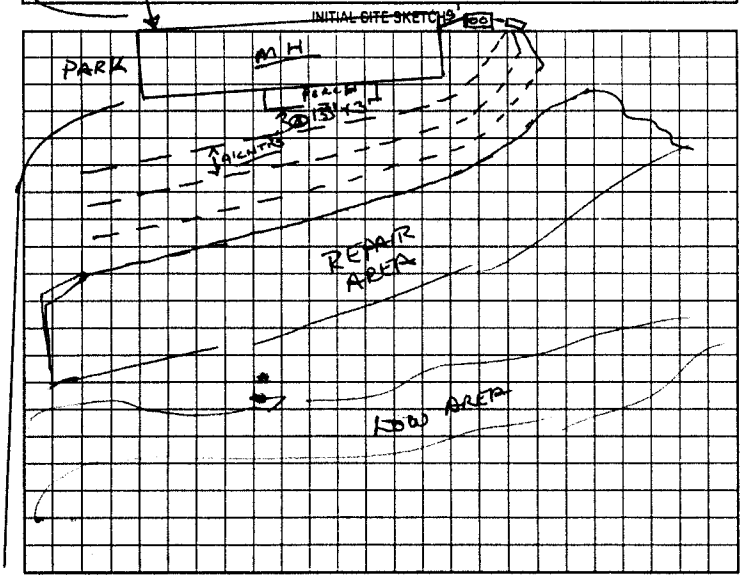

ROAD.

AS BUILT SKETCH

- SYSTEM INSTALLED AS SHOWN
- UPPER LINE DEEP AT 53"
- SOIL CHARACTERISTICS AT THAT DEPTH APPEAR TO BE PROV. SUITABLE.

Permit can be suspended or revoked if any false information is supplied toward securing the permit/any unauthorized changes are made to the site/any unauthorized changes are made in the installation of the system. Improvement Permit with plat valid without expiration. Improvement Permit with site plan valid for sixty months. Authorization to Construct is valid for a period equal to that of Improvement Permit – not to exceed sixty months.

Signed: X Danny Lambeth date

Improvement Permit by: Wesley Sparks RS. date 5/30/00

Authorization to Construct by: Wesley Sparks RS. date 5/30/00

Installed by: BARRY SIGMON

Operation Permit by: STEVE HENDRICK date 7-28-00

Existing System Inspection by: date

HEALTH DEPT. COPY: WHITE OWNER COPY (FINAL): YELLOW OWNER COPY (INITIAL): PINK