ICHD - ENVIRONMENTAL HEALTH DIVISION

Statesville Office (704) 878-5305 Mooresville Office (704) 660-3625 PERMIT # 2023-29492

SEPTIC: IMPROVEMENT PERMIT / AUTHORIZATION TO CONSTRUCT / OPERATION PERMIT / EXISTING SYSTEM Repair PIN # 4712 -- 53 -- 1309

APPLICANT/OWNER: Aaron Williams APPLICANT ADDRESS: 1239 Eufola Rd, Statesville, NC 28677

SITE ADDRESS: 1239 Eufola Rd, Statesville, NC 28677 PHONE: (301) 407-5786 ALT. PHONE –

SITE DIRECTIONS: Buffalo Shoals Rd, R Eufola Rd SAP CONTROLLED: ☐ YES ☐ NO


SUBDIVISION: – SECTION: – LOT # – LOT AREA: 1 AC DESIGN FLOW: 480 L.T.A.R.: Ext

Septic Tank	1000	(gal)	STB	760	Date	6-12-23	☐ New System	☑ Repair	☐ Expansion	System Type: I	II	III	IV	V	VI	☑ Residence	No. Bedrooms 4	Water Supply
Pump Tank		(gal)	PT		Date		System Description:	Tank Replacement								☐ Business	No. Persons 8	☐ Private
Pump Make		Model			Serial #		Repair System Description:									☐ Other	No. Employees	☑ Public
# Nitrification Fields	Ext	# Lines	Ext		Linear Ft	Ext	Maintenance Agreement Required:		☐ YES	☑ NO						☐ Slab	☐ Crawl Space	☐ Community
Trench Width	Ext	Trench Bottom Depth(Low side)		Ext	Gravel Depth	N/A	☑ GRAVITY	☐ PRESSURE								☑ Basement w/plumbing		☐ Basement w/o plumbing

Comments / Conditions: Pump, crush fill old tanks. Cut off bottom two lines that go off the property. Property must be marked before signing AC.


INITIAL SITE SKETCH

1=50

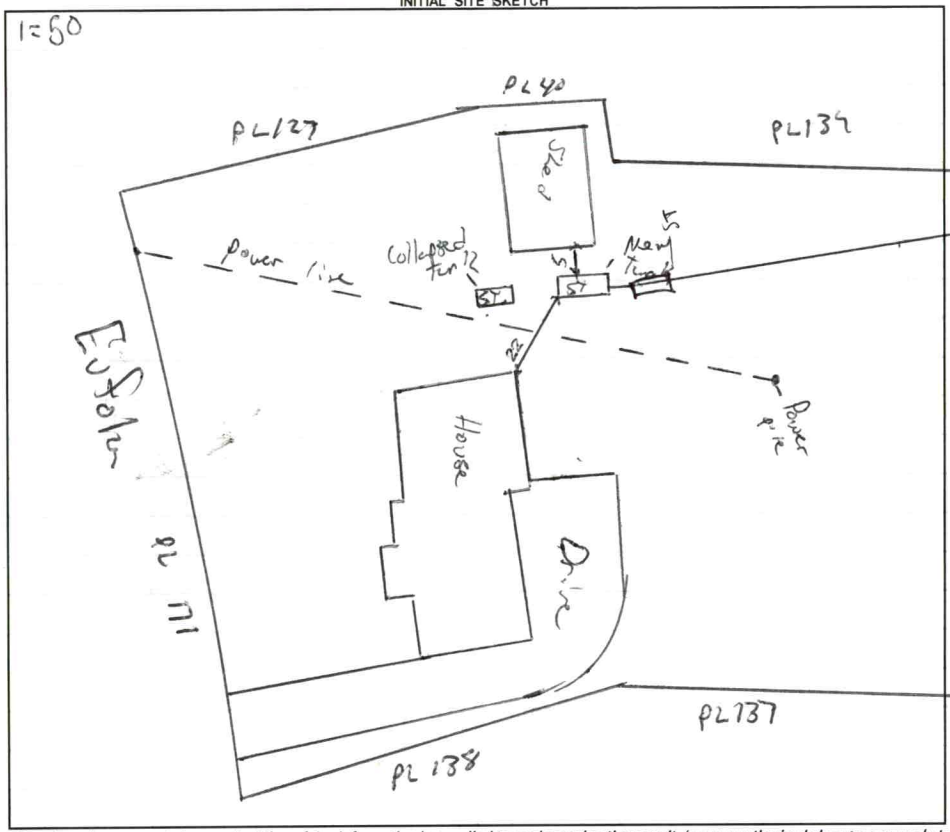

AS BUILT SKETCH

FOR SEPTIC FINAL INSPECTION CALL: 704-664-3703 between 8am-9am
the day the inspection is needed. Be sure to speak with an inspector to confirm your time.

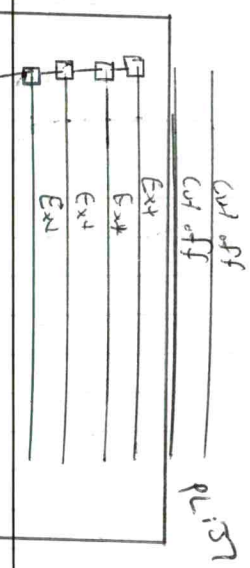

Permit can be suspended or revoked if any false information is supplied toward securing the permit / any unauthorized changes are made to the site / any unauthorized changes are made in the installation of the system. **CONTACT A LOCATOR SERVICE PRIOR TO ANY EXCAVATION**

☐ **IMPROVEMENT PERMIT** ***with plat*** *valid without expiration.* ☑ **IMPROVEMENT PERMIT** ***with site plan*** *valid for 60 mos.* ☑ **AUTHORIZATION TO CONSTRUCT** *valid for period equal to IMPROVEMENT PERMIT--not to exceed 60 mo.*

Owner / Applicant Signature: Online Signature Date: Installed by: Neill Stutts

IMPROVEMENT PERMIT by: [signature] Date: 7/6/23 OPERATION PERMIT by: Sydney Holland Date: 7/21/23

AUTHORIZATION TO CONSTRUCT by: [signature] Date: 7/14/23 Existing System Inspected by: Date:

FOR SEPTIC FINAL INSPECTION: CALL 704-664-3703 between 8am-9am the day the inspection is needed.

Item	Date	Initials
Drain Lines Checked		
Tanks Checked		
Pressure Manifold or Valve Box Checked		
Pressure Head Set		
Electrical Checked		
Floats Set		
Alarm Checked		
Maintenance Contract Needed? Y / N		
Comments:		

Repairs Only	
	State Code
Failing System Code	
Type of Distribution	G or P
Type of Failure/Malfunction	
Primary Cause of Failure/Malfunction	
Age of System? _____	
Initial or Repair? _____	



Tax Map Information

• PIN	4712531309.000
• Address	1239 EUFOLA RD
• Account #	Acct 80081688
• Tax Owner	POOLE ROGER DALE ETAL
• Mailing Address	159 MAXWELL LN
•	STATESVILLE, NC 28677
• GIS Owner	POOLE ROGER D ETAL
• Deed Info	2809 / 610 - WD - 20210430
• Tax Acres	1 AC
• Lot #	
• Description	N SIDE EUFOLA RD
• Zoning	RA
• Old Parcel #	
• Bldg Value	$231,400
• OBXF Value	$4,590
• Land Value	$32,500
• Total Value	$268,490
• Defer Value	$0
• Tax Districts	-ALLCNTY FIRE- -


IREDELL COUNTY, NC

MAP FOR REFERENCE ONLY
NOT A LEGAL DOCUMENT

Iredell County, North Carolina makes no claims and no warranties, expressed or implied, concerning the validity or accuracy of the GIS data presented on this map.

Geometry updated 06/05/2023
Data updated 06/05/2023

Print map scale is approximate. Critical layout or measurement activities should not be done using this resource.

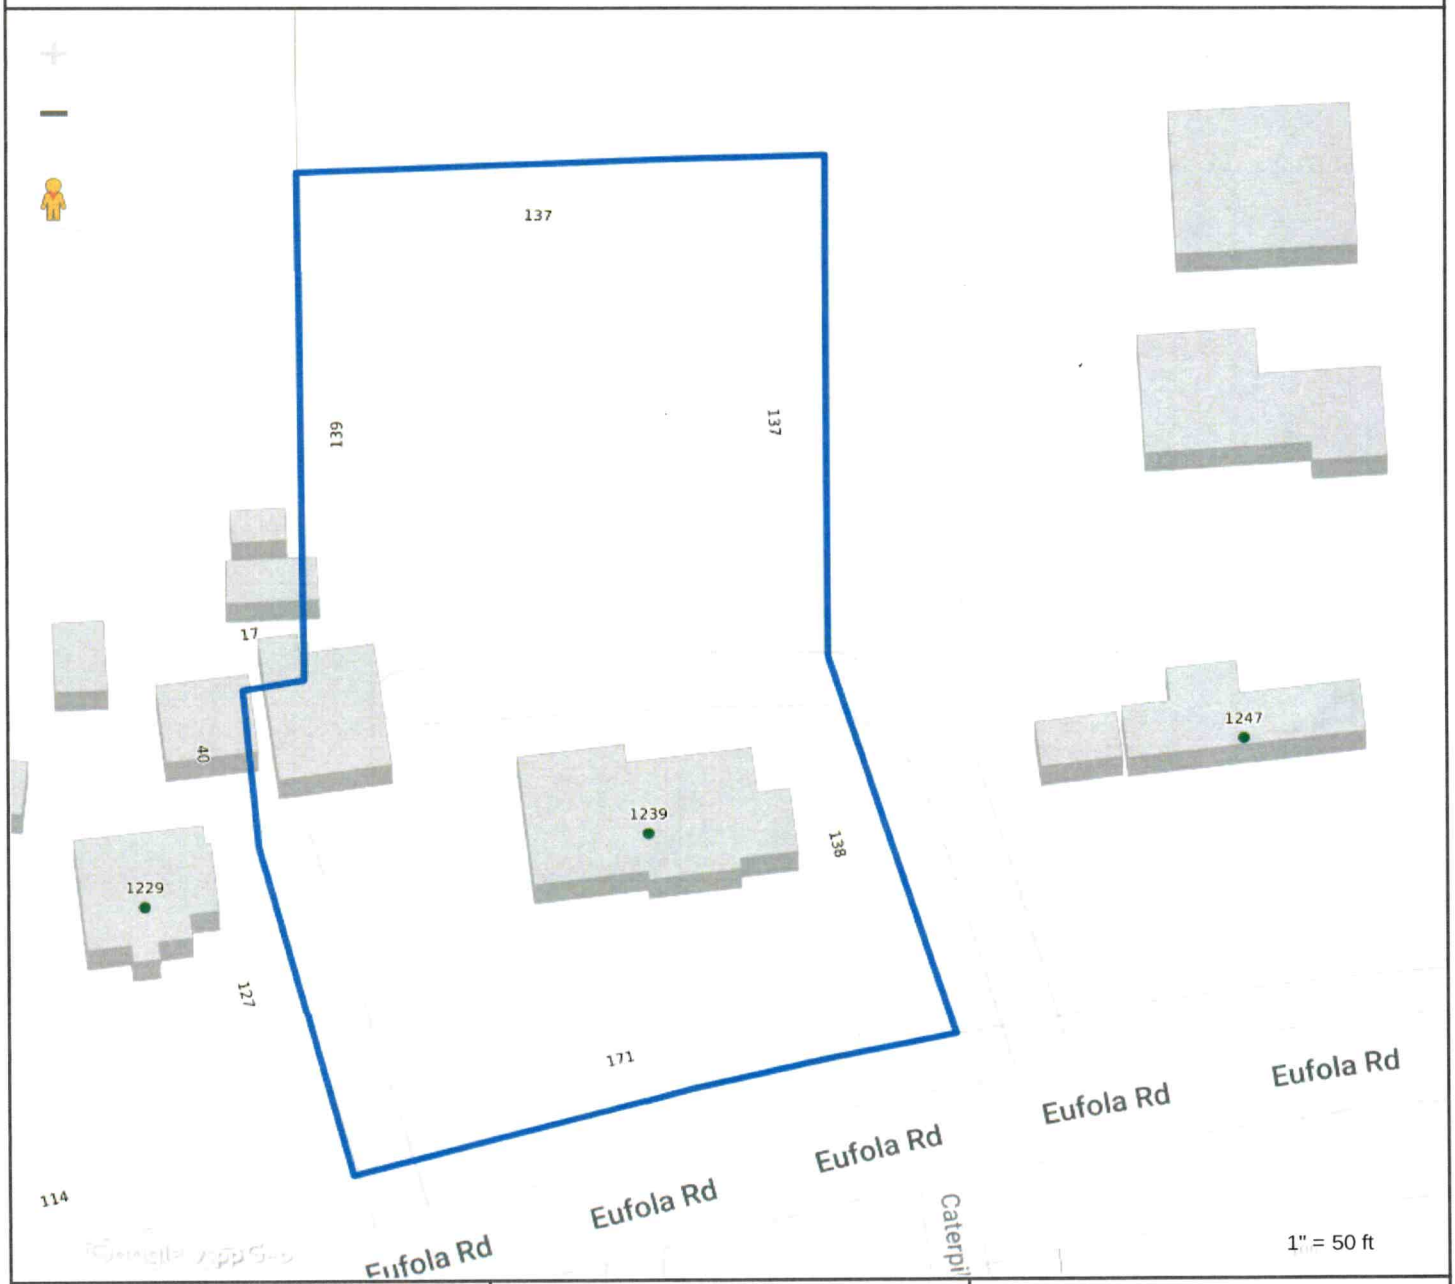

Tax Map Information

• PIN	4712531309.000
• Address	1239 EUFOLA RD
• Account #	Acct 80081688
• Tax Owner	POOLE ROGER DALE ETAL
• Mailing Address	159 MAXWELL LN
•	STATESVILLE, NC 28677
• GIS Owner	POOLE ROGER D ETAL
• Deed Info	2809 / 610 - WD - 20210430
• Tax Acres	1 AC
• Lot #	
• Description	N SIDE EUFOLA RD
• Zoning	RA
• Old Parcel #	
• Bldg Value	$231,400
• OBXF Value	$4,590
• Land Value	$32,500
• Total Value	$268,490
• Defer Value	$0
• Tax Districts	-ALLCNTY FIRE- -

IREDELL COUNTY, NC


MAP FOR REFERENCE ONLY
NOT A LEGAL DOCUMENT


Iredell County, North Carolina makes no claims and no warranties, expressed or implied, concerning the validity or accuracy of the GIS data presented on this map.

Geometry updated 06/05/2023
Data updated 06/05/2023

Print map scale is approximate. Critical layout or measurement activities should not be done using this resource.

1239 Eufola

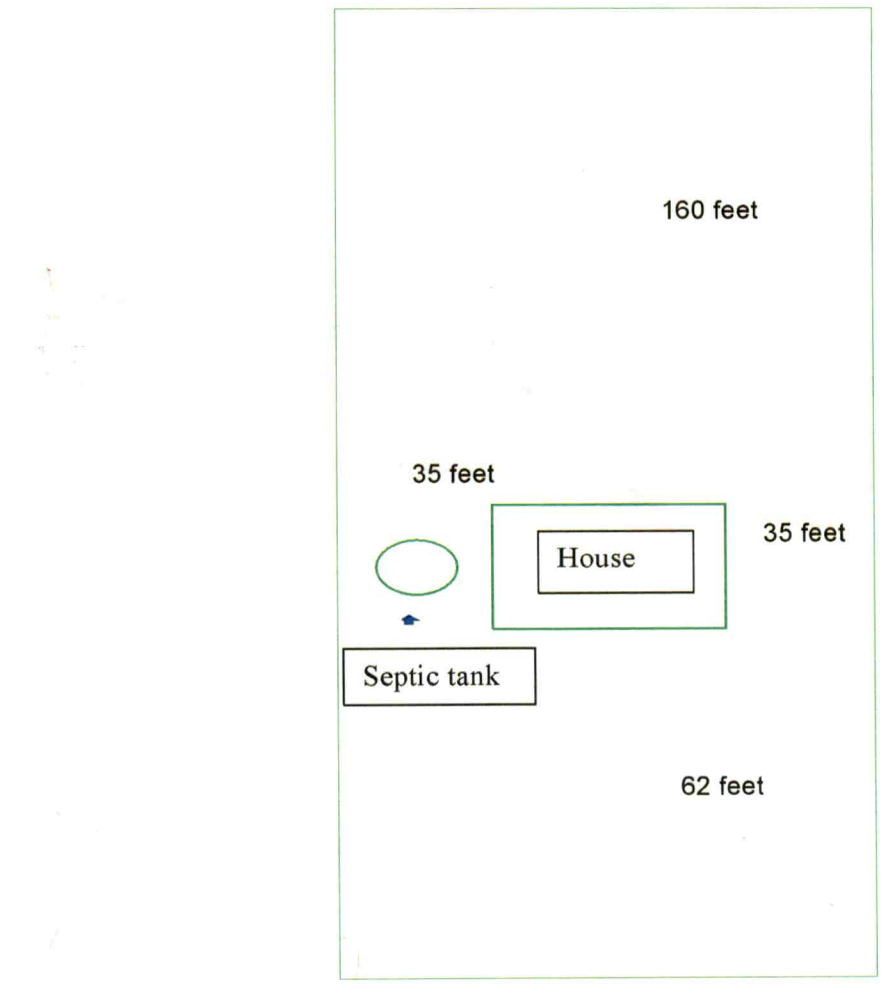


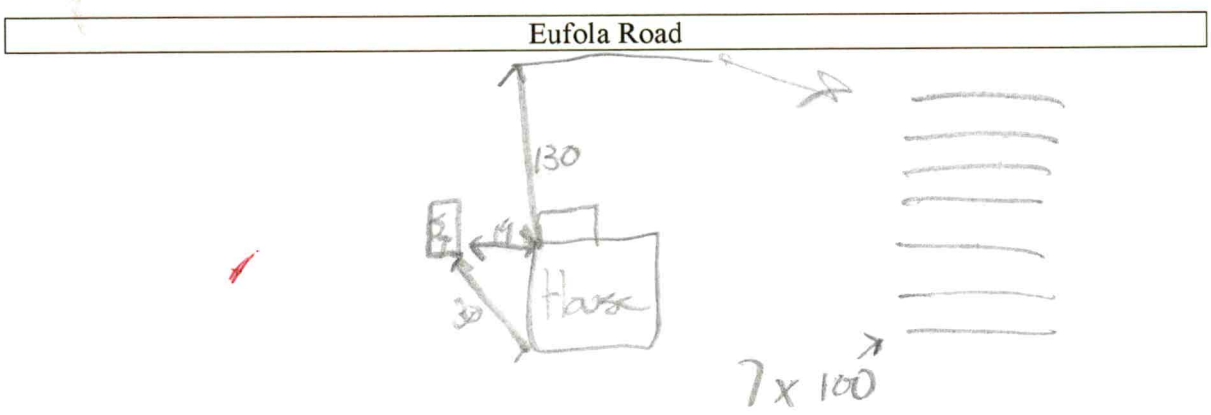

Claims 600ft is out there

Statesville, NC 28677

2,201 sqft

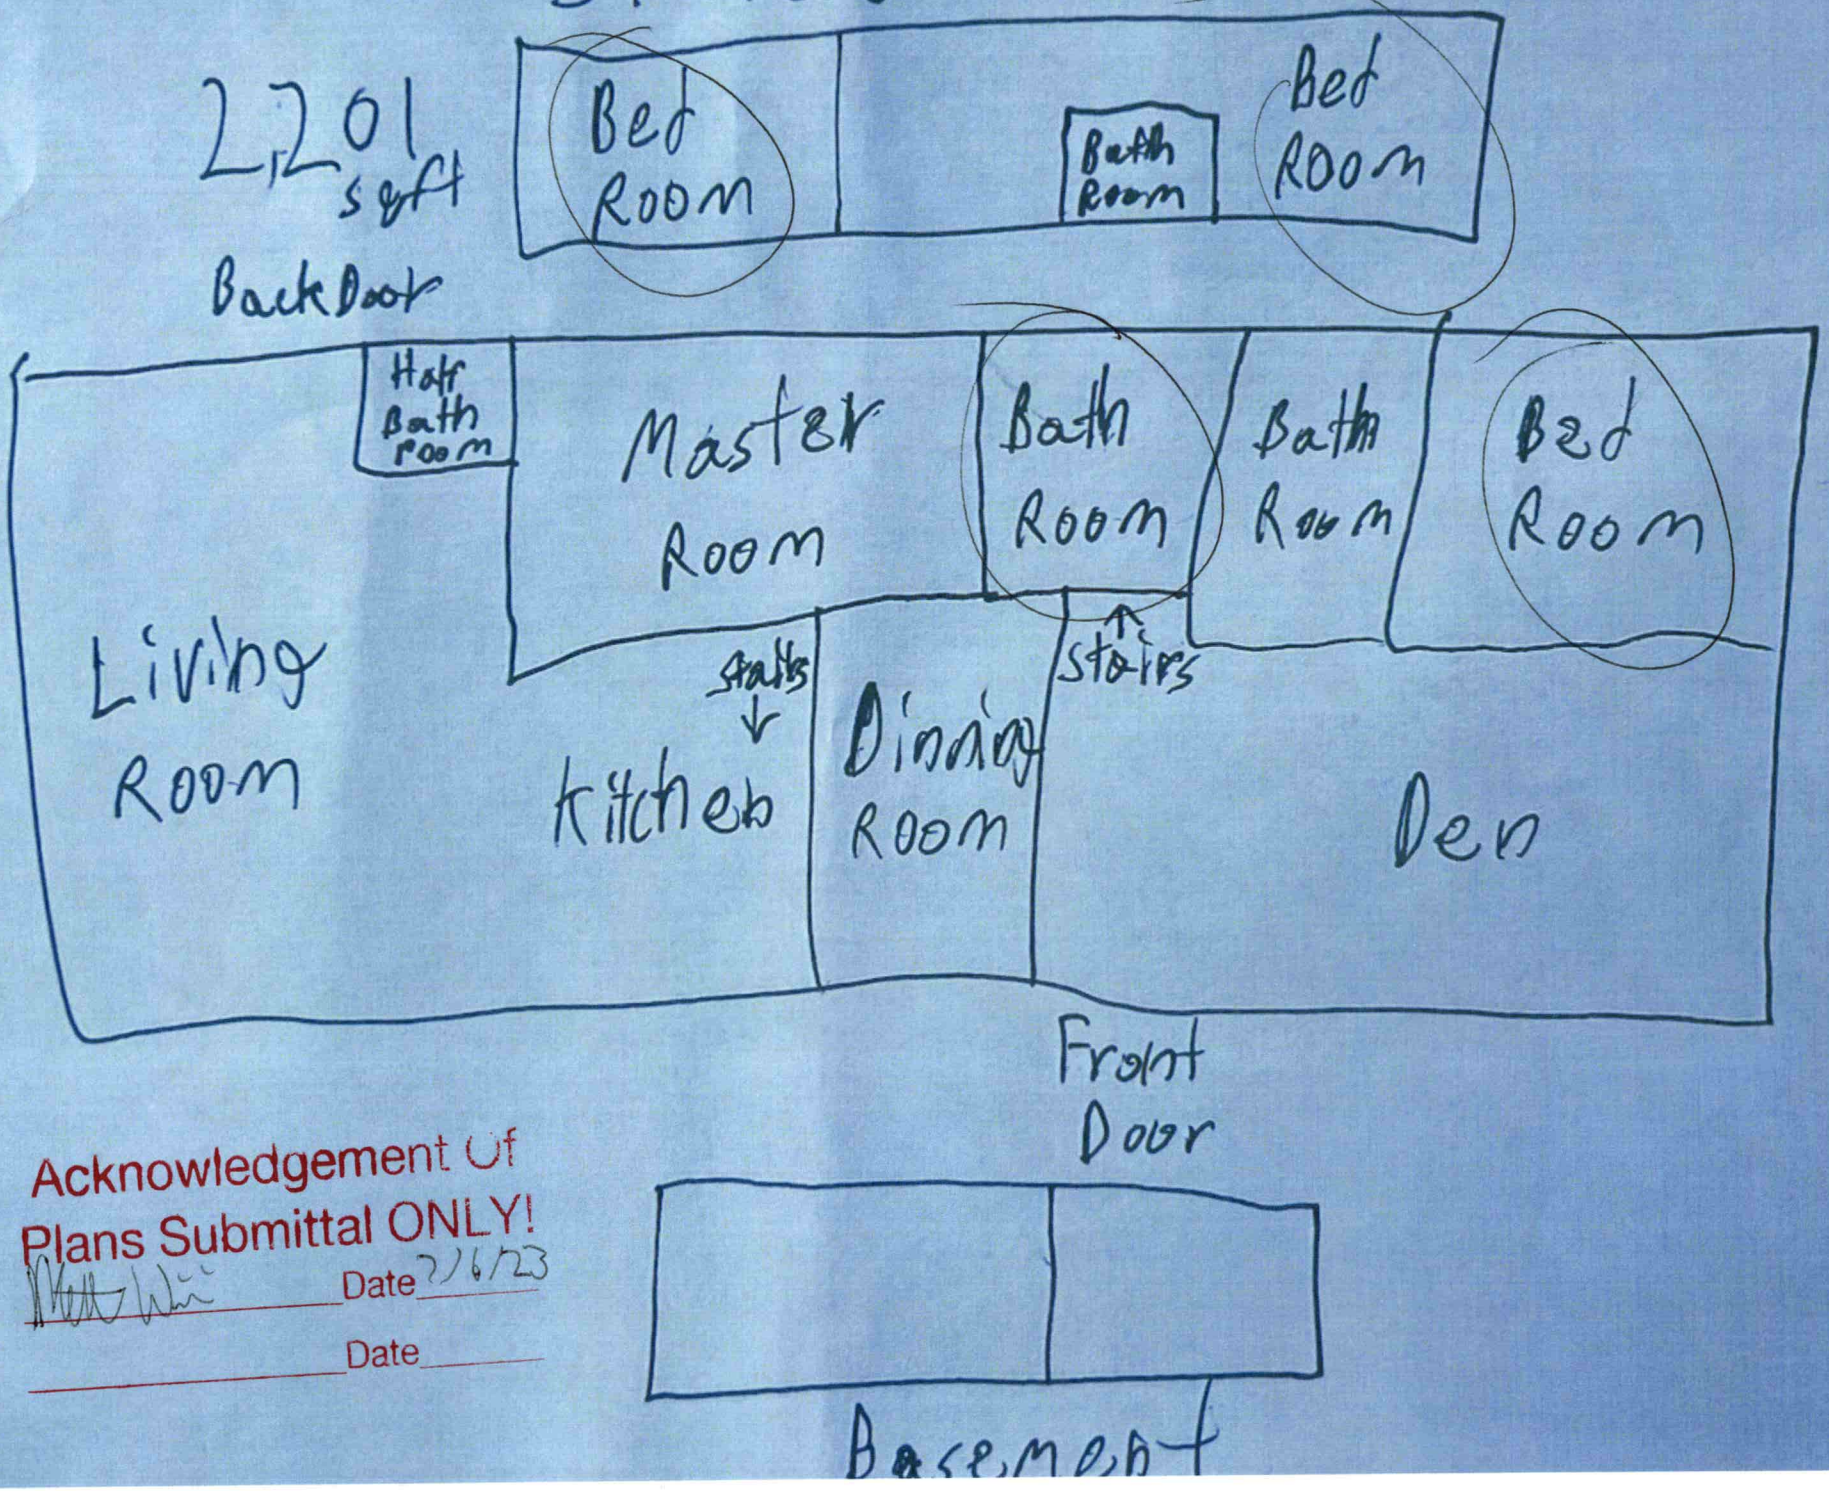

Acknowledgement Of
Plans Submittal ONLY!

Date 2/6/23

Date