IREDELL COUNTY HEALTH DEPARTMENT

Statesville Office (704) 878-5305 Mooresville Office (704) 660-3625 PERMIT # 218308

IMPROVEMENT PERMIT / AUTHORIZATION TO CONSTRUCT / OPERATION PERMIT / EXISTING SYSTEM

PIN # 4712539329

APPLICANT: Gloria Batz APPLICANT ADDRESS: 1271 Eufola Rd.

SITE ADDRESS: 1271 Eufola Rd, PHONE: 828-244-6217 ALT. PHONE: N/A

SITE DIRECTIONS: Buffalo Shoals TR Eufola Property on right past Low Lane


SUBDIVISION: N/A SECTION: N/A LOT # N/A LOT AREA: 2.37 acres DESIGN FLOW: 360gpd L.T.A.R.: 0.25

Septic Tank	1000 (gal)	STB	No 0	Date	4-12-16	☐ New System	☐ Repair	☑ Expansion	System Type: I II (III) IV V VI	☑ Residence	No. Bedrooms 3
Pump Tank	n/a (gal)	PT	n/a	Date	n/a	System Description:	25% Reduction			☐ Business	No. Persons 6
Pump Make	n/a	Model	Polylok	Serial #	PL-66	Repair System Description:	25% Reduction			☐ Other	No. Employees
# Nitrification Fields	1	# Lines	2	Linear Ft:	180	Maintenance Agreement Required:	☐ YES	☑ NO		☐ Slab	☑ Crawl Space
Trench Width	36"	Max. Trench Bottom Depth	27"	Gravel Depth	N/A		☑ GRAVITY	☐ PRESSURE		☐ Basement w/plumbing	☐ Basement w/o plumbing

Water Supply: ☑ Private ☐ Public ☐ Community

Comments / Conditions: Pump & crush existing septic tank. Cut & dam off existing drainline 50' from well as shown below. Set new septic tank and D-box @ location shown below. Install 180' of 25% Reduction system on contour with serial distribution. Install trench bottoms @ 27" on high side.

INITIAL SITE SKETCH

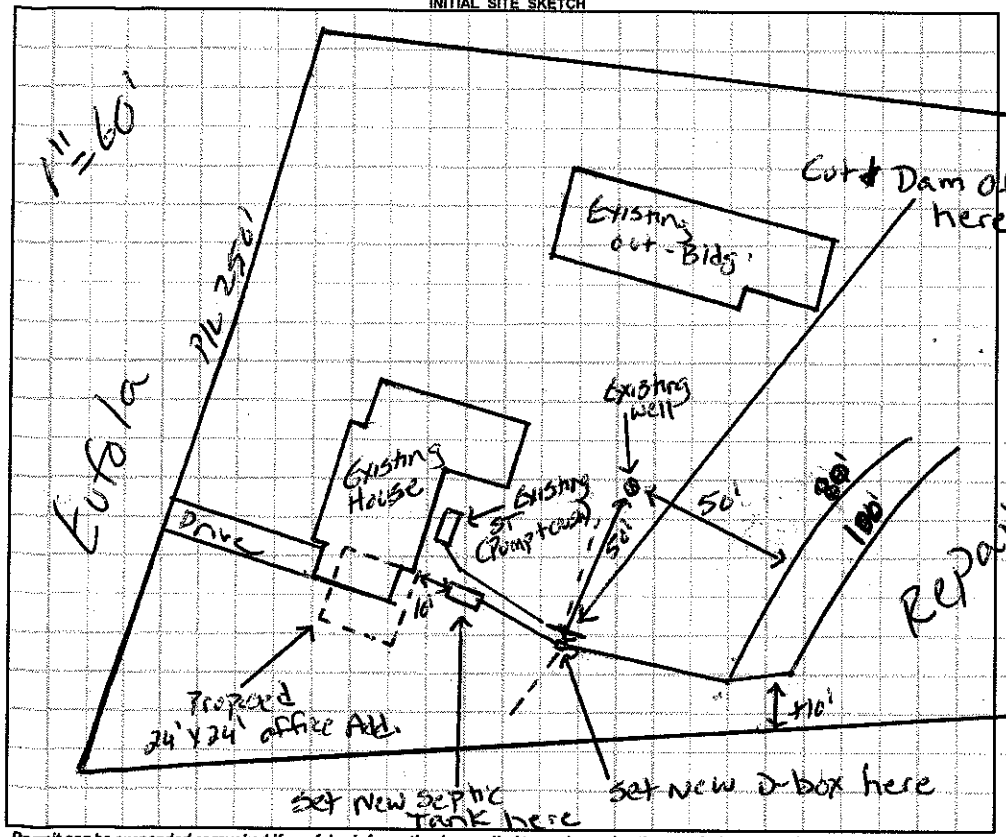

AS BUILT SKETCH

Permit can be suspended or revoked if any false information is supplied toward securing the permit / any unauthorized changes are made to the site / any unauthorized changes are made in the installation of the system. CONTACT A LOCATOR SERVICE PRIOR TO ANY EXCAVATION

☐ IMPROVEMENT PERMIT with plat valid without expiration. ☑ IMPROVEMENT PERMIT with site plan valid for 60 mos. ☑ AUTHORIZATION TO CONSTRUCT valid for period equal to IMPROVEMENT PERMIT--not to exceed 60 mo.

Owner / Applicant Signature: Gloria Batz Date:

IMPROVEMENT PERMIT by: Justin Henderson Date: 6-3-16

AUTHORIZATION TO CONSTRUCT by: Justin Henderson Date: 6-3-16

Installed by: Maiden Grading & Septic

OPERATION PERMIT by: Date: 06/15/16

Existing System Inspected by: Date:

Health Dept. Copy - WHITE Applicant (Final Approval) - YELLOW Applicant (Conditional Approval) - PINK