IREDELL COUNTY HEALTH DEPARTMENT

STATESVILLE 704-878-5305 MOORESVILLE 704-664-5281

IMPROVEMENT PERMIT / CERTIFICATE OF COMPLETION / OPERATION PERMIT / EXISTING SYSTEM INSPECTION

PROPERTY DESCRIPTION NO. 22811 DATE 1-16-96 TAX MAP NO. 3Q-5A-1 Watershed: ☐ Yes ☑ No

OWNER OR CONTRACTOR LORI CORDELL PHONE: Business _____ Home _____

ADDRESS 187 LOW LANE, STATESVILLE, NC 28677

LOCATION BUFFALO SHOALS ROAD, TR EMFOLA RD, TR LOW LANE, 2ND TO LAST LOT ON (L)

SUBDIVISION WADE LAMBERT BLOCK / SECTION _____ LOT 1 LOT AREA 1.69 Ac SITE CLASS PS DESIGN FLOW 360 L.T.A.R. EXISTING

Septic Tank: 1000 Gallons; STB _____ Date _____

Pump Tank: _____ Gallons; PT _____ Date _____

Pump Make: _____ Model _____ Serial No. _____

Nitrification Field: No Fields ____ Square Feet _____ Linear Feet EXISTING

No Lines _____ Trench Width _____ Max Trench Bottom Depth _____ Gravel Depth _____

☐ New System ☐ Repair System Type: I (II) III, IV, V, VI

System Description: CONV. GRAVITY

Repair System Description: _____

Maintenance Agreement Required: ☐ Yes ☑ No

☐ Slab ☑ Crawl Space ☐ Basement w/plumbing ☐ Basement wo/plumbing

☑ House/Mod. Home No. Bedrooms 3

☑ Mobile Home No. Bathrooms 2

☐ Business No. Employees ____


☐ Other _____

Water Supply:
☑ Individual
☐ Community
☐ Public
WELL


Comments:

Comments: KEEP MH MINIMUM 5' FROM LINES

INITIAL SITE SKETCH

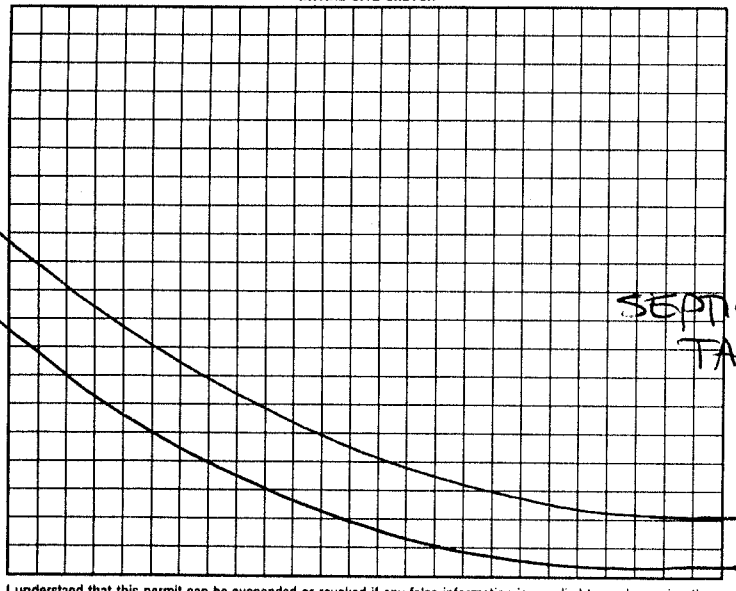

AS BUILT SKETCH

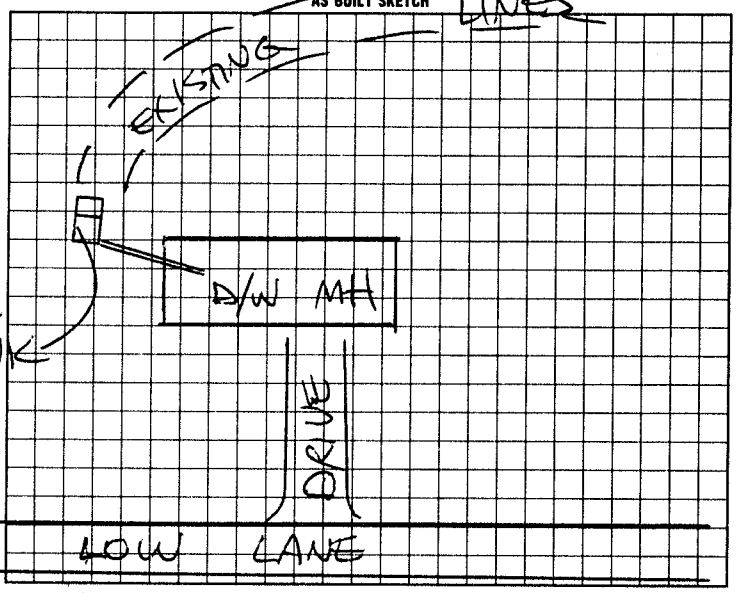

I understand that this permit can be suspended or revoked if any false information is supplied toward securing the permit/any unauthorized changes are made to the site/any unauthorized changes are made in the installation of the system.

AUTHORIZATION TO CONSTRUCT IS VALID FIVE (5) YEARS FROM DATE OF ISSUANCE. IMPROVEMENT PERMIT HAS NO EXPIRATION DATE.

Signed: _____ Installed by: _____

~~Improvement Permit by:~~ _____ date _____ ~~Certificate of Completion by:~~ _____ date _____

~~Existing System Inspection by:~~ EXISTING SYSTEM INSPECTION BY: STEVE HERRICK date 1-16-96 Operation Permit by: _____ date _____

HEALTH DEPT. COPY: WHITE INSPECTION COPY (FINAL): GREEN OWNER COPY (FINAL): YELLOW INSPECTION COPY (INITIAL): PINK OWNER COPY (INITIAL): GOLD