IREDELL COUNTY HEALTH DEPARTMENT

STATESVILLE 704-878-5305 MOORESVILLE 704-664-5281

IMPROVEMENT PERMIT / CERTIFICATE OF COMPLETION / OPERATION PERMIT / EXISTING SYSTEM INSPECTION

PROPERTY DESCRIPTION NO. 25824 Cpk6 001 DATE 1-6-97 TAX MAP NO. Pin# 4712614129 Watershed: ☐ Yes ☒ No

OWNER OR CONTRACTOR Chris Davidson PHONE: Business 528-6197 Home

ADDRESS POBox 5003 Statesville NC

LOCATION I40W TL Old Mocksville TR Buffalo Shoals Rd TR Lawn Drive 1st on left By Pond.

SUBDIVISION BLOCK / SECTION LOT LOT AREA SITE CLASS. P/S DESIGN FLOW 240 L.T.A.R. 0.32

Septic Tank: 1000 Gallons; STB 1007 Date 1-17-97

Pump Tank: Gallons; PT Date

Pump Make: Model Serial No

Nitrification Field: No Fields 1 Square Feet 600 Linear Feet 200

No Lines 2 Trench Width 36in Max Trench Bottom Depth 36in Gravel Depth —

☒ New System ☐ Repair System Type: I, II, III, IV, V, VI

System Description: Gravity Chambers

Repair System Description: Grvd. Chambers

Maintenance Agreement Required: ☐ Yes ☒ No Pump Pmt

☒ House/Mod. Home No. Bedrooms 3

☐ Mobile Home No. Bathrooms 2

☐ Business No. Employees

☐ Other

☐ Slab ☒ Crawl Space ☐ Basement w/plumbing ☐ Basement wo/plumbing


Water Supply: ☒ Individual ☒ Community ☐ Public

Comments: Keep lines on contour, 9ft on center


Per Owner - house Chambers - round upto 200ft

Comments:

INITIAL SITE SKETCH

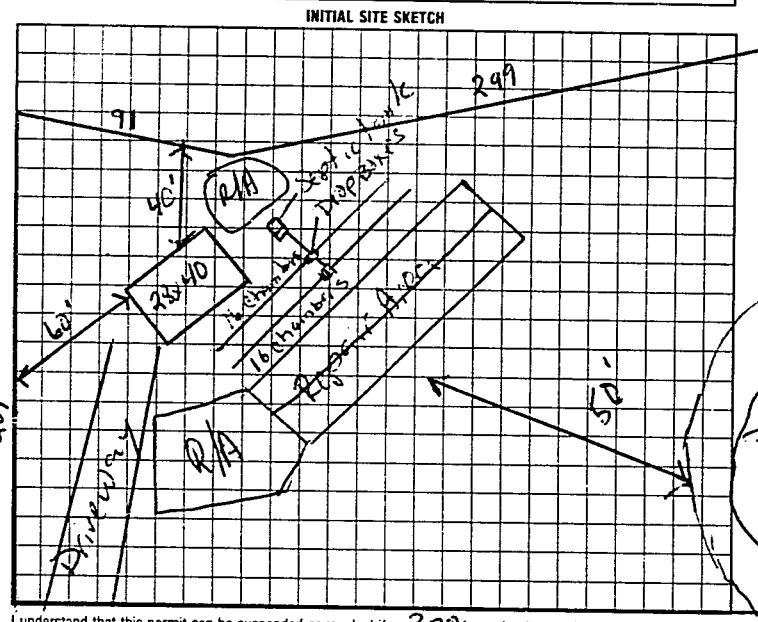

AS BUILT SKETCH

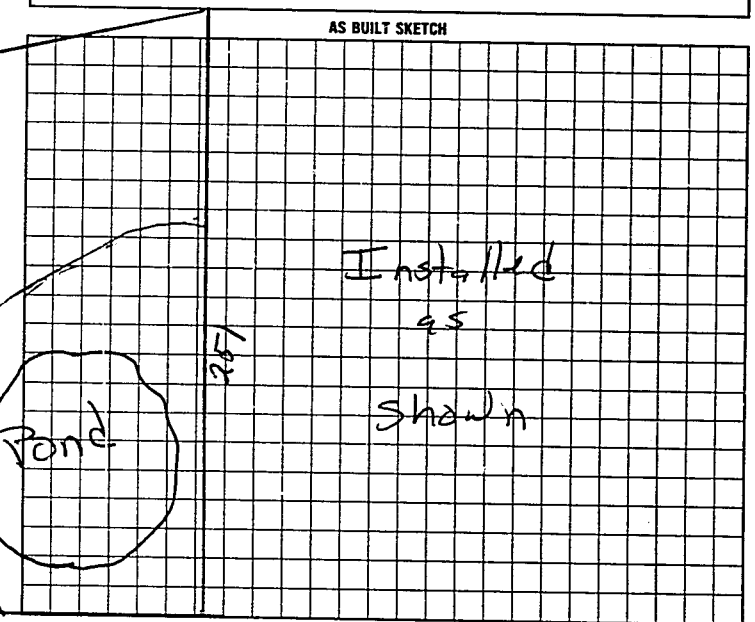

I understand that this permit can be suspended or revoked if any false information is supplied toward securing the permit/any unauthorized changes are made to the site/any unauthorized changes are made in the installation of the system. Improvement Permit is valid for 60 months from date of issuance.

Signed: Neal Kale

Improvement Permit by: Mark C Cox RS date 1-6-97

Existing System Inspection by: Mark C Cox RS date 1-6-97

ROAC Authorization to Const. expires 5yrs from issue date

Installed by: Chris Davidson

Certificate of Completion by: date

Operation Permit by: Mark C Cox date 8-28-97

HEALTH DEPT. COPY: WHITE INSPECTION COPY (FINAL): GREEN OWNER COPY (FINAL): YELLOW INSPECTION COPY (INITIAL): PINK OWNER COPY (INITIAL): GOLD

0 8 2 0 0 0