IREDELL COUNTY HEALTH DEPARTMENT

STATESVILLE 704-878-5305 MOORESVILLE 704-664-5281

IMPROVEMENT PERMIT / CERTIFICATE OF COMPLETION / OPERATION PERMIT / EXISTING SYSTEM INSPECTION

PROPERTY DESCRIPTION NO. 15601 DATE 7-27-93 TAX MAP NO. 3Q-A-21

OWNER OR CONTRACTOR Chris Davidson PHONE: Business Home

ADDRESS

LOCATION Buffalo Shoals Rd. TR Concrete St. past Eufola Rd. 1st house on L

SUBDIVISION NA BLOCK / SECTION LOT LOT AREA SITE CLASS. P.S. L.T.A.R. .28 gpd/ft²

Water Supply: ☐ Individual ☑ Community ☐ Public Share with neighbors

Septic Tank: 1000 Gallons: STB 1012 Date 4-18-93

Pump Tank: — Gallons: PT — Date —

Nitrification Field: No Fields 1 Square Feet 900 Linear Feet 300'

No Lines 2 Trench Width 36" Trench Depth 18"-24" Gravel Depth 12"

☑ New System ☐ Repair System Type: I. II. IV. V. VI

System Description: conventional, gravity

Repair System Description:

Maintenance Agreement Required: ☐ Yes ☑ No

☑ House/Mod. Home ☐ Mobile Home ☐ Business ☐ Other

No. Bedrooms 2 No. Bathrooms 1 No. Employees —

☐ Slab ☑ Crawl Space ☐ Basement w/plumbing ☐ Basement wo/plumbing

Garbage Disposal: ☐ Yes ☑ No

Auto. Dishwasher: ☑ Yes ☐ No


Auto. Washing Machine: ☑ Yes ☐ No

Other

Comments Contractor (Builder) stubbed out of house in different area than what was permitted for. This caused system to go in different than permitted. 100% Repair Area below system, conventional, gravity fed. Allowed step downs because permit did not call for lines to be kept on contour. 2(12-29-92)

INITIAL SITE SKETCH

AS BUILT SKETCH

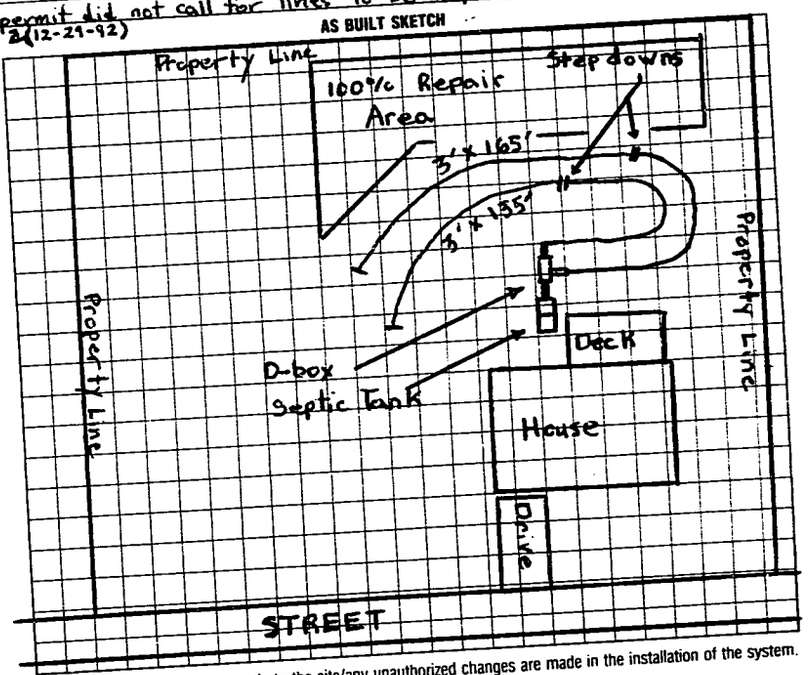

I understand that this permit can be suspended or revoked if any false information is supplied toward securing the permit/any unauthorized changes are made to the site/any unauthorized changes are made in the installation of the system. Improvement Permit is valid for 60 months from date of issuance.

Signed:

Improvement Permit by: J.C. Moore date 12-29-92

Existing System Inspection by: date

Installed by: Forest Shuford.

Certificate of Completion by: Michael J. Dennis date 7-27-93

Operation Permit by: date

HEALTH DEPT. COPY: WHITE INSPECTION COPY (FINAL): GREEN OWNER COPY (FINAL): YELLOW INSPECTION COPY (INITIAL): PINK OWNER COPY (INITIAL): GOLD

J