IREDELL COUNTY HEALTH DEPARTMENT

Statesville Phone TR 3-7271 Mooresville Phone NO 3-1271

PERMIT TO INSTALL SEPTIC TANK

Permit NO. 193 Permit Date June 10 1970

Owner Bill Hale + Stewart Address Rt. 3 - Statesville, NC.

Installed By Jerry Sitzes Address Catawba, NC


Location of Property Buffalo Shoals Rd #1004 - 1st Trailer on Right past Eufola crossroad + Rest Home.

Tank		Capacity		Length of Lines		Fixtures	
Block	( )	1000	(✓)	225'	(✓)	No. of Baths	(1)
Precast	(✓)	1250	( )	250'	( )	Dishwasher	( )
		1500	( )	Other		Garbage Grdr.	( )
		Other				Other	

NOTIFY HEALTH DEPARTMENT AT LEAST EIGHT HOURS BEFORE TANK IS TO BE INSPECTED.

Final Inspection June 10 1970 Approved (✓) Disapproved ( )

Remarks

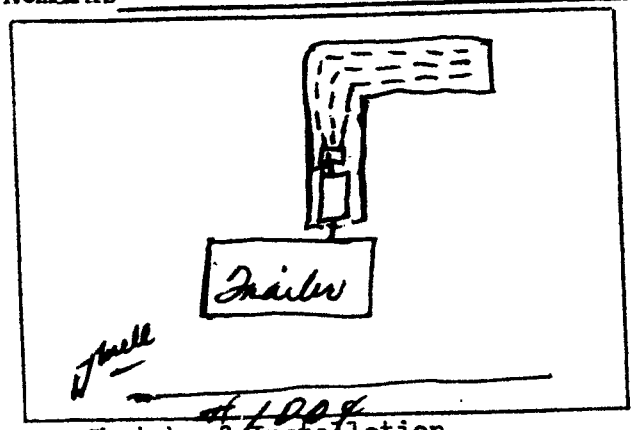

Sketch of Installation

Sanitarian