IREDELL COUNTY HEALTH DEPARTMENT

STATESVILLE 704-878-5305 MOORESVILLE 704-664-5281

IMPROVEMENT PERMIT / CERTIFICATE OF COMPLETION / OPERATION PERMIT / EXISTING SYSTEM INSPECTION

PROPERTY DESCRIPTION NO. 66102 DATE 5-5-97 TAX MAP NO. 4712 67 0346 Watershed: ☒ Yes ☐ No

OWNER OR CONTRACTOR Steven S. Lamberth PHONE: Business Home 704-528-4415 WSIV PA

ADDRESS 1228 Eufola Rd Statesville, N.C.

LOCATION Buffalo Shoules Rd to mustang Dr. 4th lot on RT

SUBDIVISION Steven Silamberth BLOCK / SECTION PHASE LOT 4 LOT AREA .59 acres SITE CLASS. PS DESIGN FLOW 240 L.T.A.R. .3

Septic Tank: 1000 Gallons; ST Date 3-10-97

Pump Tank: Gallons; PT Date

Pump Make: Model Serial No.

Nitrification Field: No Fields 1 Square Feet 810 Linear Feet 270

No Lines 3 Trench Width 36" Max Trench Bottom Depth 36" Gravel Depth 12"

☑ New System ☐ Repair System Type: I, II, III, IV, V, VI

System Description: Conv. Gravity

Repair System Description: " "

Maintenance Agreement Required: ☐ Yes ☑ No

☐ House/Mod. Home ☑ Mobile Home ☐ Business ☐ Other

No. Bedrooms 2 No. Bathrooms 2 No. Employees


☐ Slab ☑ Crawl Space ☐ Basement w/plumbing ☐ Basement wo/plumbing

Water Supply: ☑ Individual ☐ Community ☐ Public


Comments:

Comments:

INITIAL SITE SKETCH

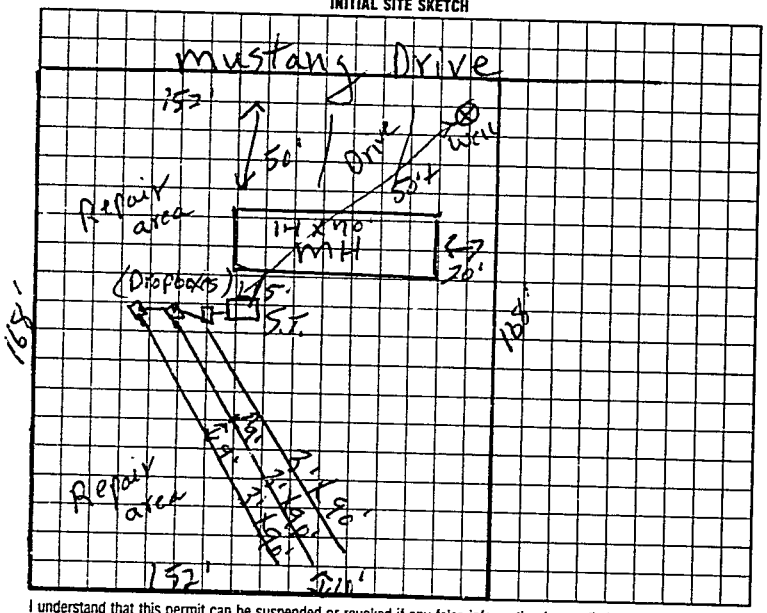

AS BUILT SKETCH

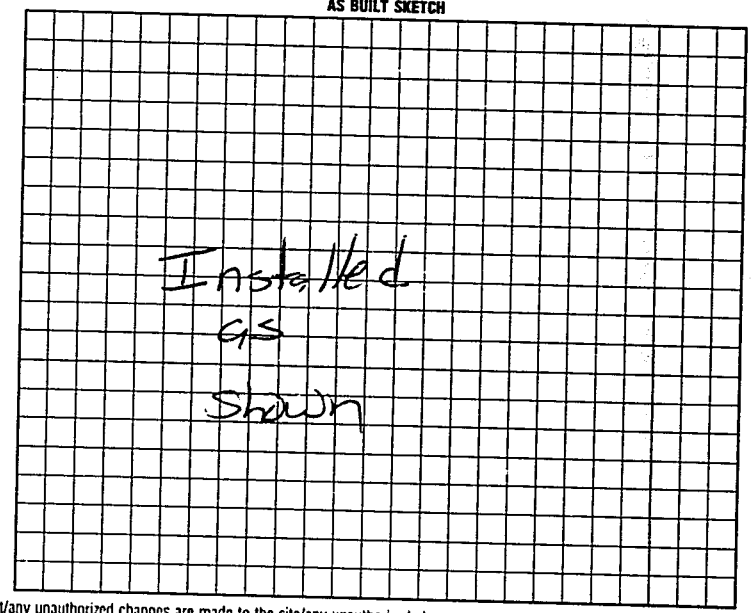

I understand that this permit can be suspended or revoked if any false information is supplied toward securing the permit/any unauthorized changes are made to the site/any unauthorized changes are made in the installation of the system. Improvement Permit is valid for 60 months from date of issuance.

Signed: X Danny Fortner

Improvement Permit by: E. C. Moore date 5-5-97

~~Authorization~~ Existing System Inspection by: E. C. Moore date 5-5-97

to court.

Installed by: Steven Lamberth

Certificate of Completion by: date

Operation Permit by: Mark C. Oates RS date 6-10-97

HEALTH DEPT COPY WHITE INSPECTION COPY (FINAL) GREEN OWNER COPY (FINAL) YELLOW INSPECTION COPY (INITIAL) PINK OWNER COPY (INITIAL) GOLD

Authorization to court Expires 60 mos fm. issue.