IREDELL COUNTY HEALTH DEPARTMENT

STATESVILLE 704-878-5305 MOORESVILLE 704-664-5281

IMPROVEMENT PERMIT / AUTHORIZATION TO CONSTRUCT / OPERATION PERMIT / EXISTING SYSTEM INSPECTION

PERMIT# 140465 PIN# 4712-62-0551 CELL DANNY DATE 2-15-07

OWNER OR APPLICANT STEVEN S. LAMBRETH PHONE: Business 704-402-4207 Home 704-528-4418

ADDRESS 122 MUSTANG DRIVE, STATESVILLE, NC 28677 528-0832

LOCATION BUFFALO SHOALS ROAD, TR, EUFOLA ROAD, TL, MUSTANG DRIVE, 2ND DRIVE ON RIGHT

SUBDIVISION LAMBRETH BLOCK / SECTION 2 LOT 3 LOT AREA 152' x 169' SITE CLASS. PS DESIGN FLOW 360 L.T.A.R. 0.20 GPD/FT2

Septic Tank: EXISTING Gallons; STB _____ Date _____

Pump Tank: _____ Gallons; PT _____ Date _____

Pump Make: _____ Model _____ Serial No. _____

Nitrification Field: No Fields 1 Square Feet 600 Linear Feet 200

No Lines THREE Trench Width 36" Max Trench Bottom Depth 36" Gravel Depth 12" ☒ Gravity ☐ Pressure

☐ New System ☐ Repair ☒ Expansion System Type: I II III IV V VI

System Description: CONVENTIONAL GRAVITY

Repair System Description: 50% REDUCTION, LOW-PRESSURE

Maintenance Agreement Required: ☐ Yes ☒ No

☐ House/Mod. Home No. Bedrooms 3

☒ Mobile Home No. Persons ____

☐ Business No. Employees ____

☐ Other _____


Water Supply: ☒ Individual ☐ Public ☐ Community WELL

☐ Slab ☒ Crawl Space ☐ Basement w/plumbing ☐ Basement wo/plumbing


Comments/Conditions: (1) EXPAND EXISTING SYSTEM AS SHOWN USING TWO NEW DROP BOXES FOR SERIAL DISTRIBUTION (2) AN "ACCEPTED SYSTEM" MAY ALSO BE USED.

Comments/Conditions: (1) V'D LAST 2 LINES OK.

INITIAL SITE SKETCH

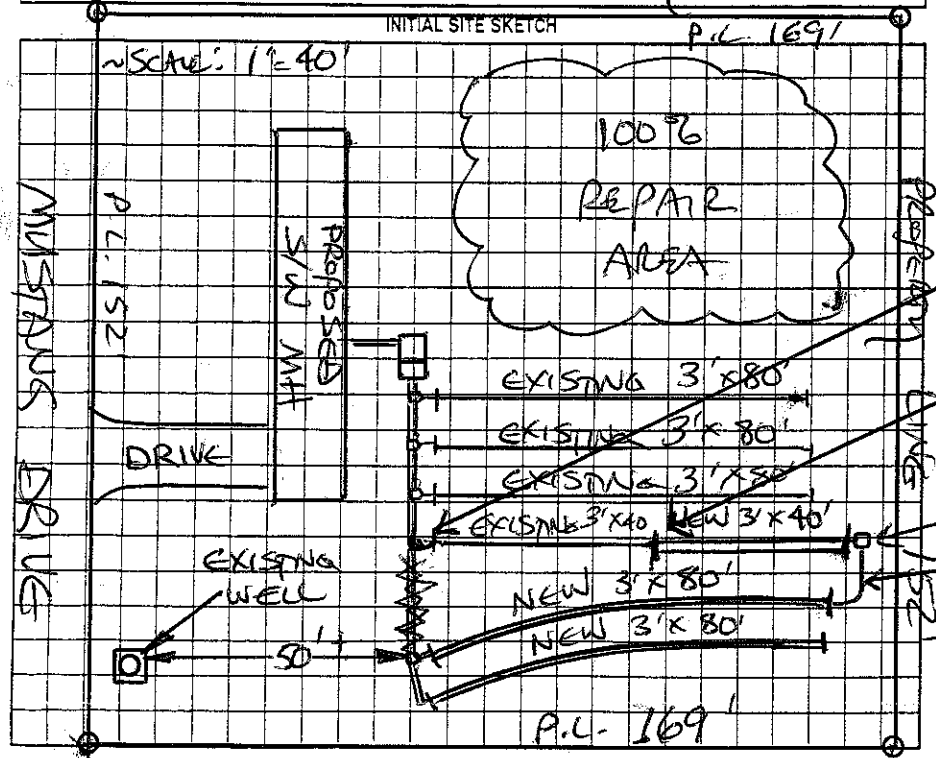

AS BUILT SKETCH

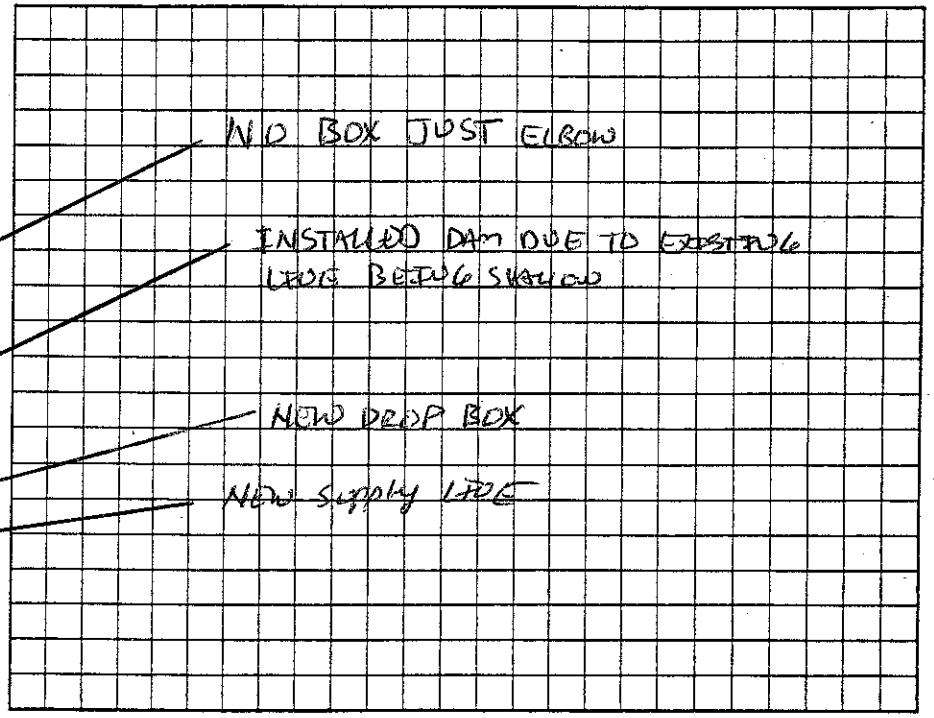

Permit can be suspended or revoked if any false information is supplied toward securing the permit/any unauthorized changes are made to the site/any unauthorized changes are made in the installation of the system. Improvement Permit with plat valid without expiration ☐ Improvement Permit with site plan valid for sixty months ☐ Authorization to Construct is valid for a period equal to that of Improvement Permit – not to exceed sixty months.

Signed: Steven Lambreth date 2-16-07

Improvement Permit by: STEVE HEDRICK date 2-15-07

Authorization to Construct by: STEVE HEDRICK date 2-15-07

Installed by: DANNY LAMBERT

Operation Permit by: _____ date 2-28-07

Existing System Inspection by: _____ date _____

HEALTH DEPT. COPY: WHITE OWNER COPY (FINAL): YELLOW OWNER COPY (INITIAL): PINK