IREDELL COUNTY HEALTH DEPARTMENT

STATESVILLE 704-878-5305 MOORESVILLE 704-664-5281

IMPROVEMENT PERMIT / CERTIFICATE OF COMPLETION / OPERATION PERMIT / EXISTING SYSTEM INSPECTION

PROPERTY DESCRIPTION NO. 25297 DATE 10-18-96 TAX MAP NO. 3Q-A-58 Pt Watershed: ☑ Yes ☐ No

OWNER OR CONTRACTOR Steven Lamberth PHONE: Business Home 528-4418

ADDRESS 1228 Eufola Rd Statesville, N.C.

LOCATION Buffalo Shoals TR Eufola Rd TL mustang Dr. on Rt.

SUBDIVISION Lamberth property BLOCK / SECTION LOT 3 LOT AREA 152 X 169 SITE CLASS. PS DESIGN FLOW 240 L.T.A.R. .3

Septic Tank: 1000 Gallons; STB 794 Date 11-14-96
Pump Tank: Gallons; PT Date
Pump Make: Model Serial No.
Nitrification Field: No Fields 1 Square Feet 840 Linear Feet 280
No Lines 4 Trench Width 36" Max Trench Bottom Depth 24" Gravel Depth 12"

☑ New System ☐ Repair System Type: I, II, III, IV, V, VI
System Description: Conv. Gravity
Repair System Description: " "
Maintenance Agreement Required: ☐ Yes ☑ No


☐ House/Mod. Home No. Bedrooms 3
☑ Mobile Home No. Bathrooms 2
☐ Business No. Employees
☐ Other
☐ Slab ☑ Crawl Space ☐ Basement w/plumbing ☐ Basement wo/plumbing

Water Supply: ☐ Individual ☑ Community ☐ Public


Comments:

Comments:

INITIAL SITE SKETCH

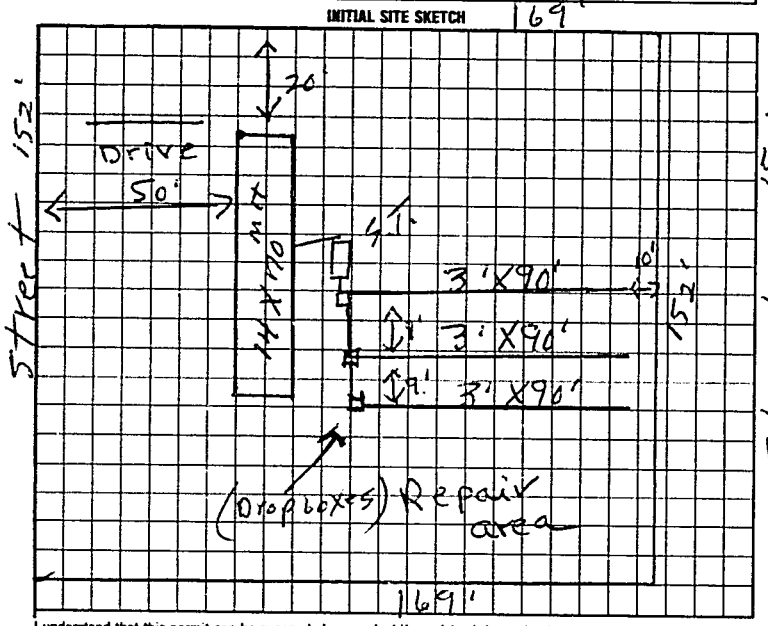

AS-BUILT SKETCH

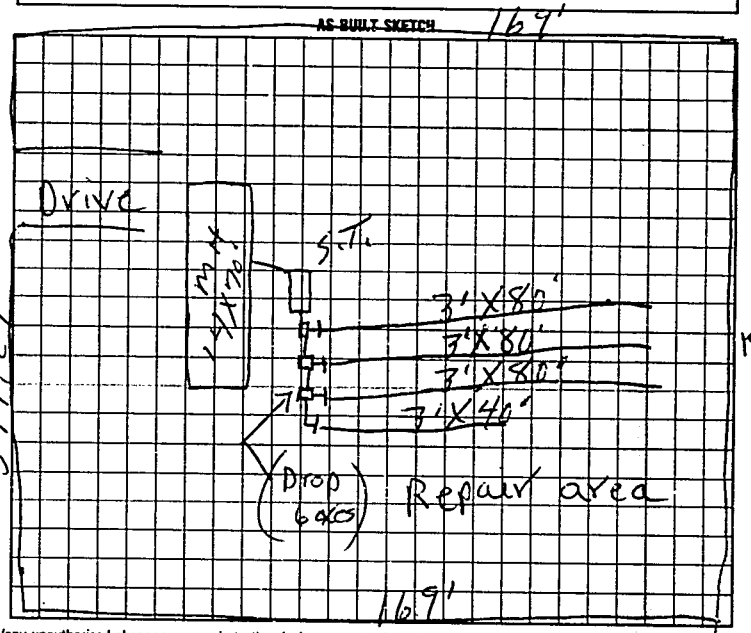

I understand that this permit can be suspended or revoked if any false information is supplied toward securing the permit/any unauthorized changes are made to the site/any unauthorized changes are made in the installation of the system.

Signed: Steven D Lamberth

Improvement Permit by: L. C. Moore date 10-18-96

Authorization Existing System Inspection by: L. C. Moore date 10-18-96

Installed by: Danny Lamberth

Certificate of Completion by: date

Operation Permit by: L. C. Moore date 1-21-97

HEALTH DEPT. COPY: WHITE INSPECTION COPY (FINAL): GREEN OWNER COPY (FINAL): YELLOW INSPECTION COPY (INITIAL): PINK OWNER COPY (INITIAL): GOLD

to Const.

Authorization to Const. Expires 60 mos from issue

1 S 1 1 0 0