IREDELL COUNTY HEALTH DEPARTMENT

STATESVILLE 704-878-5305 MOORESVILLE 704-664-5281

IMPROVEMENT PERMIT / CERTIFICATE OF COMPLETION / OPERATION PERMIT / EXISTING SYSTEM INSPECTION

PROPERTY DESCRIPTION NO. 21739 DATE 2-12-96 TAX MAP NO. 3Q-A-58 (PART OF) Watershed IVPA - No

OWNER OR CONTRACTOR STEVEN S. LAMBERTH PHONE: Business Home 528-4418

ADDRESS 1228 EUFOLA ROAD, STATESVILLE, NC 28677

LOCATION BUFFALO SHOALS RD, TR, EUFOLA ROAD, 2ND DRIVE ON LEFT, 2ND LOT ON (R)

SUBDIVISION STEVEN S. LAMBERTH BLOCK / SECTION LOT 2 LOT AREA 10.1 x 237' SITE CLASS PS DESIGN FLOW 240' L.T.A.R. 0.25 GPD/FT²

Septic Tank: 1000 Gallons; STB 1012 Date 11-27-95
Pump Tank: Gallons; PT Date
Pump Make: Model Serial No.
Nitrification Field: No Fields 1 Square Feet 960 Linear Feet 320
No Lines 4 Trench Width 36" Max Trench Bottom Depth 18-36" Gravel Depth 12"

☑ New System ☐ Repair System Type: I II III IV V VI
System Description: CONVENTIONAL SEPTIC
Repair System Description: CONV. GRAVITY
Maintenance Agreement Required Yes No


☐ House/Mod. Home ☐ Mobile Home ☐ Business ☐ Other
No. Bedrooms 2 No. Bathrooms 2 No. Employees
Slab ☑ Crawl Space ☐ Basement w/plumbing ☐ Basement wo/plumbing

Water Supply: ☑ Individual ☐ Community ☐ Public WELL

Comments: ① KEEP SYSTEM MINIMUM 100' FROM WELL - ② USE THREE! FLOW DIVIDER TEES TO ACHIEVE EQUAL DISTRIBUTION INTO EACH OF FOUR 80' LINES

Comments:

INITIAL SITE SKETCH

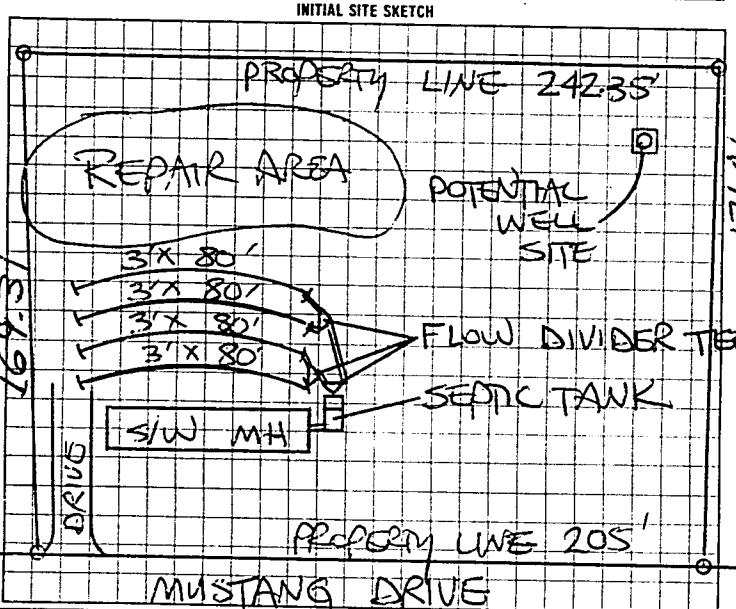

AS BUILT SKETCH

Same as initial Sketch

I understand that this permit can be suspended or revoked if any false information is supplied toward securing the permit; any unauthorized changes are made to the site/any unauthorized changes are made in the installation of the system.

AUTHORIZATION TO CONSTRUCT IS VALID FIVE (5) YEARS FROM DATE OF ISSUANCE. IMPROVEMENT PERMIT HAS NO EXPIRATION DATE

Signed X Steven Lamberth

Improvement Permit by: STEVE FREDRICK date 2-12-96

Authorization to Construct / ~~Existing System Inspection~~ by: STEVE FREDRICK date 2-12-96

Installed by: B. Sigmon Const.

~~Certificate of Completion by:~~ date

Operation Permit by: R. C. Moore date 3-12-96

HEALTH DEPT. COPY WHITE — INSPECTION COPY (FINAL) GREEN — OWNER COPY (FINAL) YELLOW — INSPECTION COPY (INITIAL) PINK — OWNER COPY (INITIAL) GOLD

8911100