IREDELL COUNTY HEALTH DEPARTMENT

STATESVILLE 704-878-5305 MOORESVILLE 704-664-5281

IMPROVEMENT PERMIT / CERTIFICATE OF COMPLETION / OPERATION PERMIT / EXISTING SYSTEM INSPECTION

PROPERTY DESCRIPTION NO. 20497 DATE 4-10-95 TAX MAP NO. 3Q-A-58 Watershed: ☐ Yes ☑ No

OWNER OR CONTRACTOR Steven S. Lambeth PHONE: Business _____ Home 528-4418

ADDRESS 1228 Eufola Rd. Statesville, N.C. 28677

LOCATION I40W TL Old Mtn. Rd. TR Buffalo Shoals Rd TR Eufola Rd. lot on Left across from Low Lane.

SUBDIVISION NA BLOCK / SECTION — LOT — LOT AREA 12 acres SITE CLASS. P.S. DESIGN FLOW 240 L.T.A.R. .3 gpd/ft²

Septic Tank: 1000 Gallons; STB 1012 Date 2-29-95
Pump Tank: — Gallons; PT — Date —
Pump Make: — Model — Serial No. —
Nitrification Field: No Fields 1 Square Feet 800 Linear Feet 266'
No Lines 3 Trench Width 36" Max Trench Bottom Depth 24" Gravel Depth 12"

☑ New System ☐ Repair System Type: I, II, III, IV, V, VI
System Description: conventional, gravity fed
Repair System Description: " "
Maintenance Agreement Required: ☐ Yes ☑ No

☐ House/Mod. Home ☑ Mobile Home ☐ Business ☐ Other
No. Bedrooms 2 No. Bathrooms 1 No. Employees ____


☐ Slab ☑ Crawl Space ☐ Basement w/plumbing ☐ Basement wo/plumbing

Water Supply: ☑ Individual ☐ Community ☐ Public

Comments: INSTALL SYSTEM SHALLOW (no deeper than 24" to trench bottom) Keep lines and trenches on contour. Keep system 5' min. from foundation of home, 10' from all property lines, and max feasable distance from any well and no closer than 50'. 100% Repair Area Below system, conventional, gravity fed.

Comments: Well located at time of inspection it is 50'± to septic system. Home not located at time of inspection. Keep home foundation min 5' from any part of septic system.

INITIAL SITE SKETCH

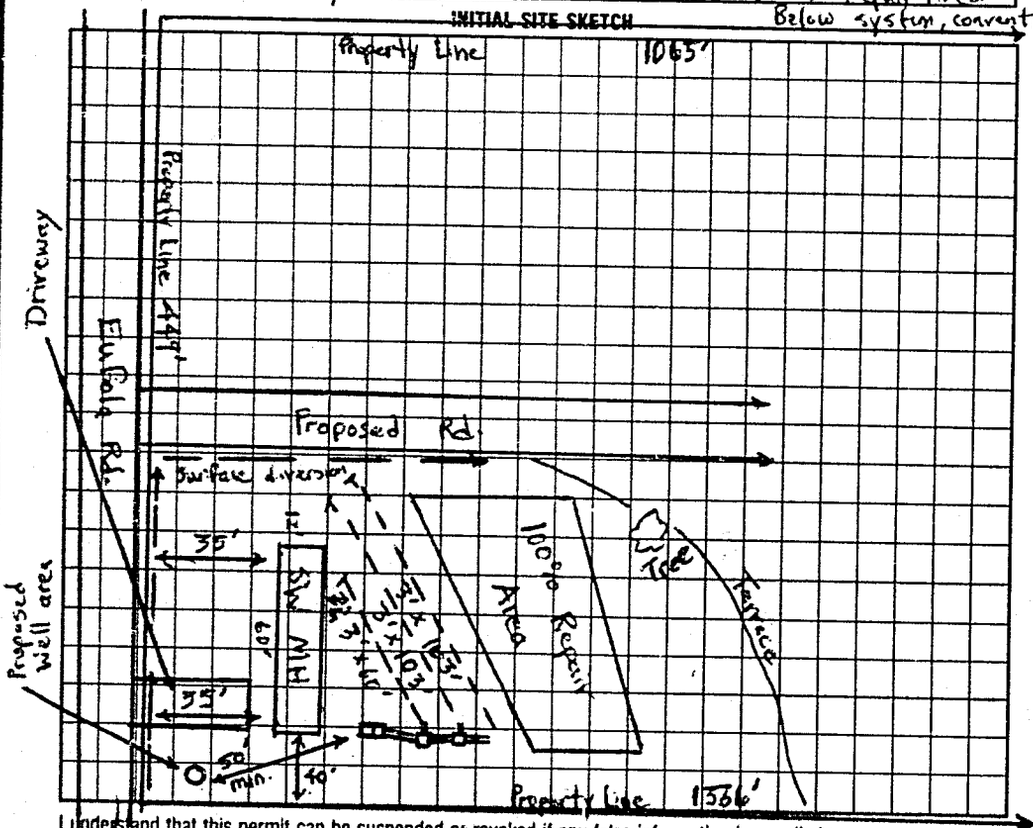

AS BUILT SKETCH

* Home and system to be placed (system installed) ≈ 10' further down hill than permitted.

SAME AS INITIAL SKETCH

I understand that this permit can be suspended or revoked if any false information is supplied toward securing the permit/any unauthorized changes are made to the site/any unauthorized changes are made in the installation of the system. Improvement Permit is valid for 60 months from date of issuance.

Signed: Danny W. Lanier

Improvement Permit by: Michael J. Dennis date 4-10-95

Existing System Inspection by: _____ date _____

Installed by: AAA Enterprises

Certificate of Completion by: Michael J. Dennis date 5-17-95

Operation Permit by: _____ date _____

HEALTH DEPT. COPY WHITE INSPECTION COPY (FINAL) GREEN OWNER COPY (FINAL) YELLOW INSPECTION COPY (INITIAL) PINK OWNER COPY (INITIAL) GOLD