IREDELL COUNTY HEALTH DEPARTMENT

Statesville Office (704) 878-5305 Mooresville Office (704) 660-3625 PERMIT # 212281

IMPROVEMENT PERMIT / AUTHORIZATION TO CONSTRUCT / OPERATION PERMIT / EXISTING SYSTEM

PIN # 4712620982

APPLICANT: Eric Ward (Freedom Homes) APPLICANT ADDRESS: 1124 Charlotte Hwy Troutman NC

SITE ADDRESS: 1280 Eufola Rd Statesville NC PHONE: 704-873-5824 ALT. PHONE: 704-883-6148

SITE DIRECTIONS: 115 S T/R old Mtn Rd T/L Buffalo Shoals Rd T/R Eufola Lot on left


SUBDIVISION: Steven S Lamberth SECTION: N/A LOT # 1 LOT AREA: 0.82ac DESIGN FLOW: 240 L.T.A.R.: Ex

Septic Tank	Ex	(gal)	STB		Date		☐ New System	☐ Repair	☐ Expansion	System Type: I	☒ II	III IV V VI	
Pump Tank		(gal)	PT		Date		System Description:	Existing					
Pump Make			Model		Serial #		Repair System Description:						
# Nitrification Fields	Ex	# Lines	Ex	Linear Ft:	Ex		Maintenance Agreement Required:	☐ YES	☒ NO				
Trench Width	Ex	Max. Trench Bottom Depth	Ex	Gravel Depth	Ex			☒ GRAVITY	☐ PRESSURE				


☒ Residence	No. Bedrooms	2	Water Supply		
☐ Business	No. Persons	4	☐ Private		
☐ Other	No. Employees		☒ Public		
☐ Slab	☒ Crawl Space		☐ Community		
☐ Basement w/plumbing			☐ Basement w/o plumbing		

Comments / Conditions: All building foundations must be 35' from any part of STS.

INITIAL SITE SKETCH

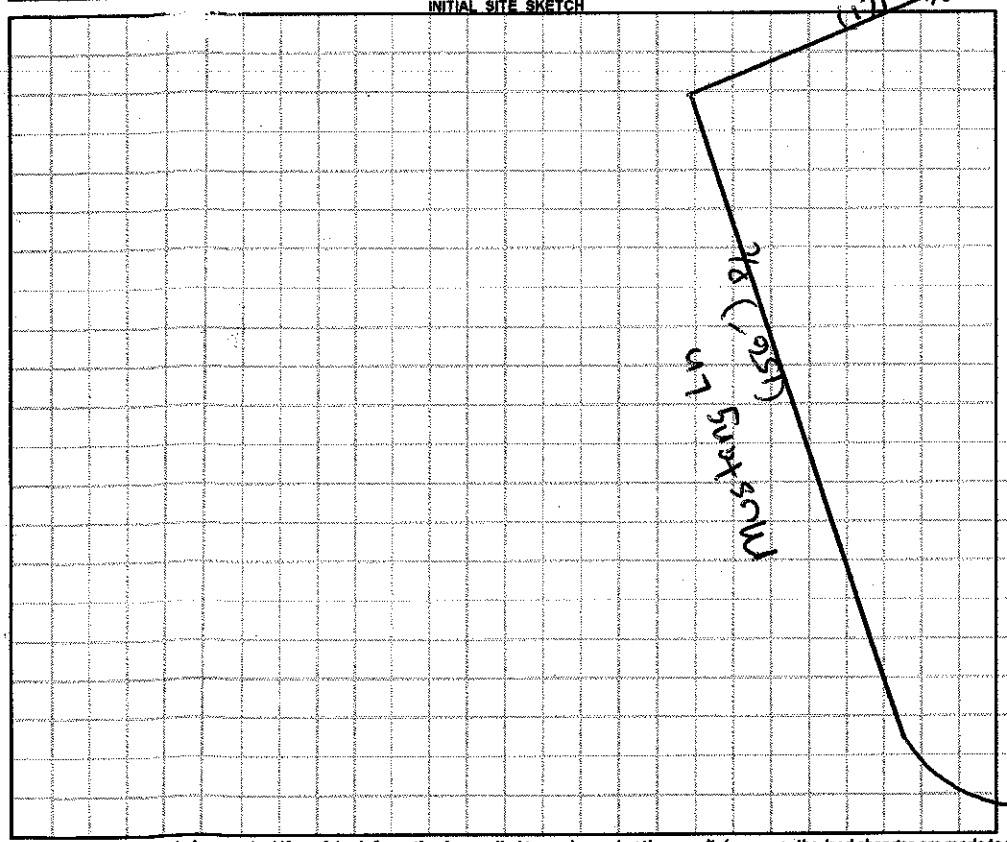

AS BUILT SKETCH

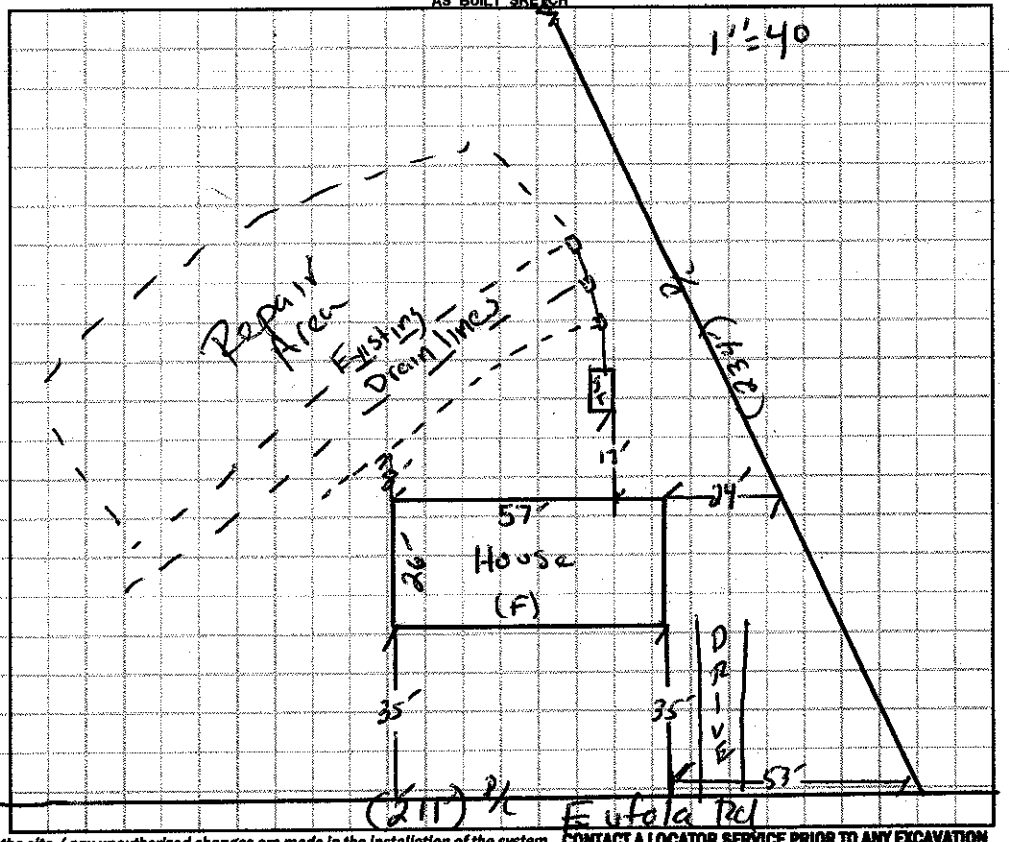

Permit can be suspended or revoked if any false information is supplied toward securing the permit / any unauthorized changes are made to the site / any unauthorized changes are made in the installation of the system. **CONTACT A LOCATOR SERVICE PRIOR TO ANY EXCAVATION**

☐ **IMPROVEMENT PERMIT** *with plot valid without expiration.* ☐ **IMPROVEMENT PERMIT** *with site plan valid for 60 mos.* ☐ **AUTHORIZATION TO CONSTRUCT** *valid for period equal to IMPROVEMENT PERMIT--not to exceed 60 mo.*

Owner / Applicant Signature: Eric McCall Date: Installed by:

IMPROVEMENT PERMIT by: Date: OPERATION PERMIT by: Date:

AUTHORIZATION TO CONSTRUCT by: Date: Existing System Inspected by: Robert A Lee Date: 08/31/15

Health Dept. Copy - WHITE Applicant (Final Approval) - YELLOW Applicant (Conditional Approval) - PINK