9:30

IREDELL COUNTY HEALTH DEPARTMENT

STATESVILLE 704-878-5305 MOORESVILLE 704-664-5281

IMPROVEMENT PERMIT / CERTIFICATE OF COMPLETION / OPERATION PERMIT / EXISTING SYSTEM INSPECTION

PROPERTY DESCRIPTION NO. 21740 DATE 12-28-95 TAX MAP NO. pt. of 3Q-A-58 Watershed: ☐ Yes ☑ No

OWNER OR CONTRACTOR Steven S. Lamberth PHONE: Business _____ Home 528-4458

ADDRESS 1228 Eufola Rd Statesville N.C. 28677

LOCATION I40W TL Old Mtn. Rd TR Buffalo Shoals Rd TR Eufola Rd TL Mustang Dr. Last lot on L.

SUBDIVISION Steven S. Lamberth BLOCK / SECTION _____ LOT #7 LOT AREA 200' x 192' SITE CLASS. PS. DESIGN FLOW 240 L.T.A.R. .25 gpd/ft²

Septic Tank: 1000 Gallons; STB 101 Date 10-16-95
Pump Tank: — Gallons; PT — Date —
Pump Make: — Model — Serial No. —
Nitrification Field: No Fields 1 Square Feet 960 Linear Feet 320'
No Lines 3 Trench Width 36" Max Trench Bottom Depth 24"-30" Gravel Depth 12"

☑ New System ☐ Repair System Type: I, II, III, IV, V, VI
System Description: conventional, gravity fed
Repair System Description: chambered gravelless system
Maintenance Agreement Required: ☐ Yes ☑ No


☐ House/Mod. Home No. Bedrooms 3
☑ Mobile Home No. Bathrooms 2
☐ Business No. Employees ____
☐ Other ____
☐ Slab ☑ Crawl Space ☐ Basement w/plumbing ☐ Basement wo/plumbing

Water Supply: ☑ Individual ☐ Community ☐ Public Shared well

Comments: Install System Shallow (no deeper than 24" deep on lower side of trench) Keep lines and trenches on contour. Keep system min. 5' from home, 10' from all property lines, and 100' from any well. Create surface diversion around system. Keep it below home, Chambered gravelless system.

Comments:

INITIAL SITE SKETCH

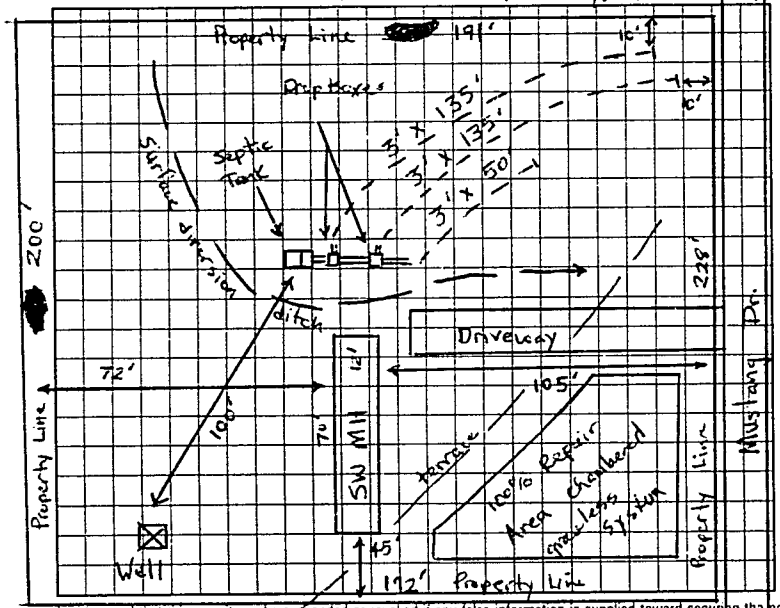

AS BUILT SKETCH

Same as initial sketch

I understand that this permit can be suspended or revoked if any false information is supplied toward securing the permit/any unauthorized changes are made to the site/any unauthorized changes are made in the installation of the system. Authorization to construct is valid for five years (5) from date of issuance. Improvement permit has no expiration date.

Signed: Steven S. Lamberth

Improvement Permit by: Michael O'Dennis date 12-28-95

Authorization to construct: Michael O'Dennis date 12-28-95

Installed by: Barry Sigmon

Certificate of Completion by: E.C. Moore date 1-24-96

Operation Permit by: _____ date _____

HEALTH DEPT. COPY. WHITE INSPECTION COPY (FINAL) GREEN OWNER COPY (FINAL) YELLOW INSPECTION COPY (INITIAL) PINK OWNER COPY (INITIAL) GOLD

091100