IREDELL COUNTY HEALTH DEPARTMENT

30-A-58/PT

STATESVILLE 704-878-5305 MOORESVILLE 704-664-5281

IMPROVEMENT PERMIT / CERTIFICATE OF COMPLETION / OPERATION PERMIT / EXISTING SYSTEM INSPECTION

PROPERTY DESCRIPTION NO. 21741 DATE 12-28-95 TAX MAP NO. pt. of 3Q-A-58 Watershed: ☐ Yes ☑ No

OWNER OR CONTRACTOR Steven S. Lamberth PHONE: Business _____ Home 528-4418

ADDRESS 1228 Eufola Rd. Statesville, N.C. 28677

LOCATION I-40W to Old Mtn. Rd. TR Buffalo Shoals Rd. TR Eufola Rd. TL Mustang Dr. 2nd lot on L.

SUBDIVISION Steven S. Lamberth BLOCK / SECTION _____ LOT 76 LOT AREA 125' x 190' SITE CLASS. P.S. DESIGN FLOW 240 L.T.A.R. .27 grd/ft²

Septic Tank: 1000 Gallons; STB 1012 Date 11-27-95 ☑ New System ☐ Repair System Type: I, II, III, IV, V, VI

Pump Tank: — Gallons; PT — Date —

Pump Make: — Model — Serial No. —

Nitrification Field: No Fields 1 Square Feet 900 Linear Feet 300

No Lines 4 Trench Width 36" Max Trench Bottom Depth 24"-30" Gravel Depth 12"

System Description: conventional, gravity fed.

Repair System Description: " "

Maintenance Agreement Required: ☐ Yes ☑ No

☐ House/Mod. Home ☑ Mobile Home ☐ Business ☐ Other

No. Bedrooms 2 No. Bathrooms 2 No. Employees _____


☐ Slab ☑ Crawl Space ☐ Basement w/plumbing ☐ Basement wo/plumbing

Water Supply: ☑ Individual ☐ Community ☐ Public Shared well next lot.

Comments: Install system shallow (not deeper than 24" deep on lower side of trench. Keep lines and trenches on contour. Keep system 5' from home, 10' from property lines, and 100' from any well. 100% Repair above and below system, conventional, gravity fed.

Comments:

INITIAL SITE SKETCH

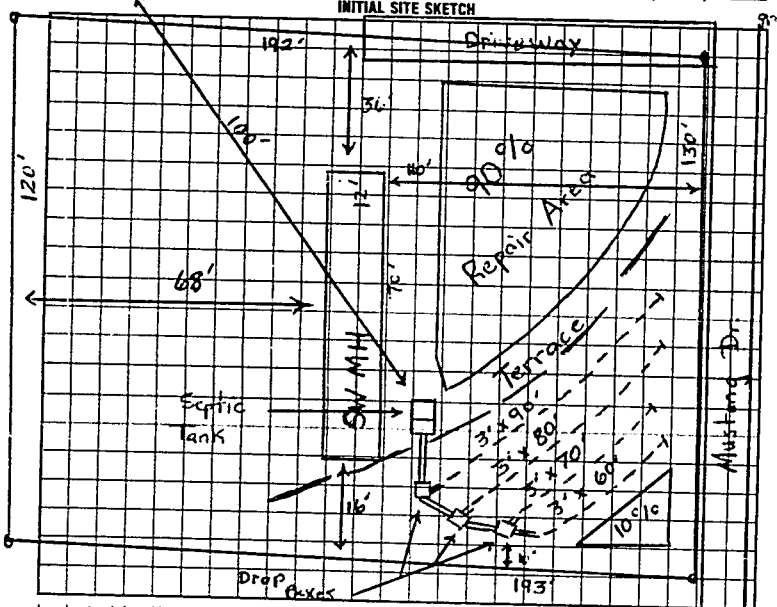

AS BUILT SKETCH

Same as initial sketch

I understand that this permit can be suspended or revoked if any false information is supplied toward securing the permit/any unauthorized changes are made to the site/any unauthorized changes are made in the installation of the system. Authorization to construct is valid five (5) years, from date of issuance. Improvement Permit has no expiration date.

Signed: Joyce C. Lamberth

Improvement Permit by: Michael Deaton date 12-28-95

Authorization to construct Michael Deaton date 12-28-95

Installed by: B. Signon Const. Co.

Certificate of Completion by: _____ date _____

Operation Permit by: C. C. Moore date 3-12-96

HEALTH DEPT COPY WHITE INSPECTION COPY (FINAL) GREEN OWNER COPY (FINAL) YELLOW INSPECTION COPY (INITIAL) PINK OWNER COPY (INITIAL) GOLD