IREDELL COUNTY HEALTH DEPARTMENT

STATESVILLE 704-878-5305 MOORESVILLE 704-664-5281

IMPROVEMENT PERMIT / CERTIFICATE OF COMPLETION / OPERATION PERMIT / EXISTING SYSTEM INSPECTION

PROPERTY DESCRIPTION NO. 21333 DATE 9-26-96 TAX MAP NO. 3Q-A-58 Pt of6 Watershed: ☑ Yes ☐ No

OWNER OR CONTRACTOR Steven S. Lamberth PHONE: Business _____ Home 528-4418 WS4-PA

ADDRESS _____

LOCATION 1213 Buffalo Shoales Rd Eufola TR Eufola 1000' TL mustang Dr. 1st Lot left

SUBDIVISION Lamberth BLOCK / SECTION _____ LOT 5 LOT AREA .5 acres SITE CLASS PS DESIGN FLOW 270 L.T.A.R. .2

Septic Tank: 1000 Property Gallons; SPB 794 Date _____

Pump Tank: _____ Gallons; PT _____ Date _____

Pump Make: _____ Model _____ Serial No. _____

Nitrification Field: No Fields 1 Square Feet 810 Linear Feet 270

No Lines 3 Trench Width 36" Max Trench Bottom Depth 36" Gravel Depth 12"

☑ New System ☐ Repair System Type: I, II, III, IV, V, VI

System Description: Conv. Gravity

Repair System Description: Conv. Gravity

Maintenance Agreement Required: ☐ Yes ☐ No

☐ House/Mod. Home No. Bedrooms 2

☐ Mobile Home No. Bathrooms 2

☐ Business No. Employees _____

☐ Other _____


☐ Slab ☑ Crawl Space ☐ Basement w/plumbing ☐ Basement wo/plumbing

Water Supply: ☑ Individual ☐ Community ☐ Public

Comments:

Comments: mobile Home & well were not on site at time of this inspection located as shown on sketch

INITIAL SITE SKETCH

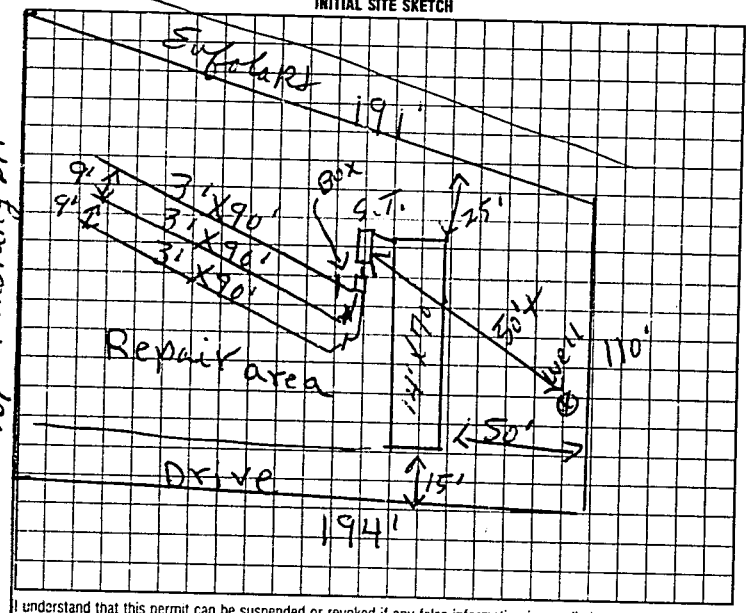

AS BUILT SKETCH

Same as initial sketch

I understand that this permit can be suspended or revoked if any false information is supplied toward securing the permit/any unauthorized changes are made to the site/any unauthorized changes are made in the installation of the system.

Signed: X Steven S Lamberth

Improvement Permit by: L.C. moore date 9-26-96

Existing System Inspection by: L.C. moore date 9-26-96

Authorization to construct

Installed by: Eric Swain

Certificate of Completion by: _____ date _____

Operation Permit by: L.C. moore date 10-1-96

Authorization to Const Expires 6 months from issue

HEALTH DEPT. COPY: WHITE INSPECTION COPY (FINAL): GREEN OWNER COPY (FINAL): YELLOW INSPECTION COPY (INITIAL): PINK OWNER COPY (INITIAL): GOLD