09452

IREDELL COUNTY HEALTH DEPARTMENT

(SEPTIC TANK) IMPROVEMENTS PERMIT AND CERTIFICATE OF COMPLETION

(Ground Absorption Sewage Disposal System -- G. S. Chapter 130-Article 13C)

OWNER OR CONTRACTOR RICHARD TEAGUE DATE 4-14-89 PERMIT NO. 14C.

PHONE: Business _____ Home _____

LOCATION Buffalo Shoals Rd. west of T.R. on Eufola Rd. - 200-300 yards on left - MH back in woods. S. R. No. _____

SUBDIVISION NAME _____ LOT NO. _____ SECTION OR BLOCK NO. _____

House ( ) Mobile Home ( ) Business ( ) Other MAY BUILD HOUSE LATER.

No. Bedrooms 3 No. Bathrooms 2

Garbage Disposal Unit Yes ( ) No ( )

Auto. Dishwasher Yes ( ) No ( )

Auto. Wash. Machine Yes ( ) No ( )

Site Suitable Yes ( ) No ( )

Lot Area 5+ acres

Character & Porosity of Soil Loam - Suitable.


Percolation Rate 30 MPI 6 Ft.

Topography Level

Depth to Water Table 10+

Rock or other impervious formations none observed.

_____ Basement with Plumbing _____ Basement without Plumbing ✓ No Basement

 

Size of Tank 1000 Gals.

Nitrification Field:
No. of Lines 3
Sq. Ft. 720 Lineal Ft. 240
Depth of Stone in Lines 12"

Water Supply: Individual ( )
Public ( )

Installed by James Hudler

I understand and agree to install septic tank system as specified on this Improvements Permit.

Signed: _____

Plot Plan of System

IMPROVEMENTS PERMIT BY Steve Brown

COMMENTS: _____

CERTIFICATE OF COMPLETION BY Steve Brown DATE 4-14-89.

EXISTING SYSTEM CHECKED BY: _____ DATE _____

CONSTRUCTION MUST COMPLY WITH ALL OTHER APPLICABLE STATE AND LOCAL REGULATIONS.

Permit is VOID if any unauthorized changes are made in installation of system and/or if any false information is supplied in making Improvements Permit.

Health Dept. Copy: White Inspection Dept. Copy: Yellow Sanitarian's Copy: Pink Owner's Copy: Gold