47415

IREDELL COUNTY HEALTH DEPARTMENT

STATESVILLE 704-878-5305 MOORESVILLE 704-664-5281

IMPROVEMENT PERMIT / CERTIFICATE OF COMPLETION / OPERATION PERMIT / EXISTING SYSTEM INSPECTION

PROPERTY DESCRIPTION NO. 16344 DATE 6-1-93 TAX MAP NO. 3Q-B-13

OWNER OR CONTRACTOR Sun-Wood Builders PHONE: Business 872-0921 Home

ADDRESS

LOCATION I-40 W TL Old Mtn. Rd. TR Buffalo Shoals Rd. TR Eufola Rd. TR Big Tree Dr. 1st Lot on R.

SUBDIVISION Woodland Acres BLOCK / SECTION LOT 1 LOT AREA 28,950 sq. ft. SITE CLASS. P.S. L.T.A.R. .35 gpd/ft²

Water Supply: ☑ Individual ☐ Community ☐ Public Well, on another lot.

Septic Tank: 1000 Gallons; STB 358 Date 5-14-93

Pump Tank: — Gallons; PT — Date —

Nitrification Field: No Fields 3 Square Feet 690 Linear Feet 230'

No Lines 3 Trench Width 36" Trench Depth 24-36" Gravel Depth 12"

☑ New System ☐ Repair System Type: I, II, III, IV, V, VI

System Description: Conventional, gravity fed.

Repair System Description:

Maintenance Agreement Required: ☐ Yes ☑ No

☐ House/Mod. Home ☑ Mobile Home ☐ Business ☐ Other

No. Bedrooms 2 No. Bathrooms 2 No. Employees —

☐ Slab ☑ Crawl Space ☐ Basement w/plumbing

Garbage Disposal: ☐ Yes ☑ No

Auto. Dishwasher: ☑ Yes ☐ No


Auto. Washing Machine: ☑ Yes ☐ No

Other ☐ Basement wo/plumbing

Comments Keep Mobile Home 5' from any part of septic system. Keep water supply line min. 10' from any part of septic system. 100% Pump to repair Above System.

INITIAL SITE SKETCH

AS BUILT SKETCH

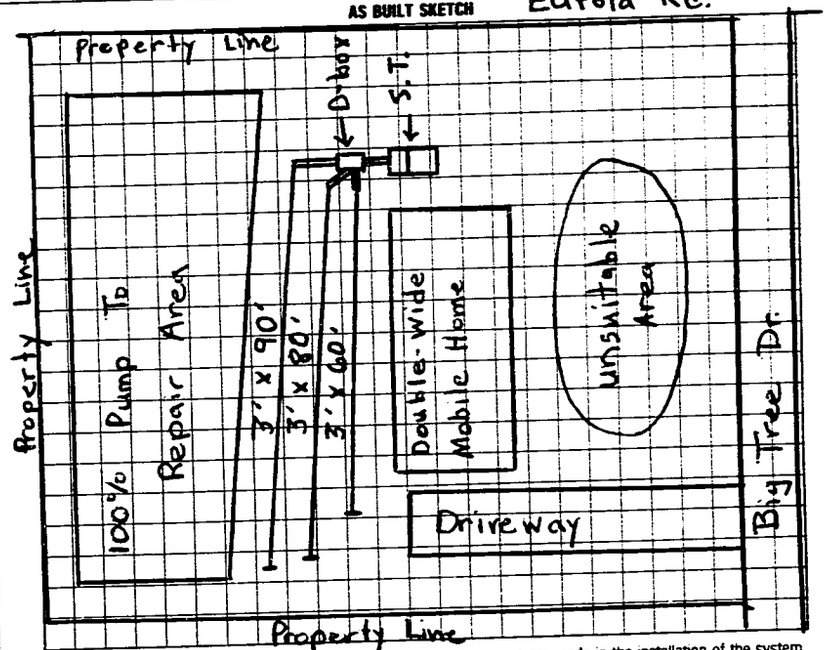

I understand that this permit can be suspended or revoked if any false information is supplied toward securing the permit/any unauthorized changes are made to the site/any unauthorized changes are made in the installation of the system. Improvement Permit is valid for 60 months from date of issuance.

Signed:

Improvement Permit by: Michael L. Dennis date 5-17-93

Existing System Inspection by: date

Installed by: A-1 Backhoe

Certificate of Completion by: Michael L. Dennis date 6-1-93

Operation Permit by: date

HEALTH DEPT. COPY: WHITE INSPECTION COPY (FINAL): GREEN OWNER COPY (FINAL): YELLOW INSPECTION COPY (INITIAL): PINK OWNER COPY (INITIAL): GOLD