IREDELL COUNTY HEALTH DEPARTMENT

STATESVILLE 704-878-5305 MOORESVILLE 704-664-5281

IMPROVEMENT PERMIT / CERTIFICATE OF COMPLETION / OPERATION PERMIT / EXISTING SYSTEM INSPECTION

PROPERTY DESCRIPTION NO. 16566 DATE 7-9-93 TAX MAP NO. 3Q-5-B

OWNER OR CONTRACTOR Audrey M. Owens PHONE: Business Home 871-1075

ADDRESS Box 422 Dogwood Estates Statesville, N.C. 28677

LOCATION I40W TL 018 Mtn. Rd. TR Buffalo Shoals Rd. TR Eufola Rd. TR Low Lane Rd. 5th Lot on L.

SUBDIVISION Wade S. Lamberth BLOCK / SECTION LOT 5 LOT AREA .52 acre SITE CLASS. P.S. L.T.A.R. .35 gpd/ft²

Water Supply: ☑ Individual ☐ Community ☐ Public Well To Be Located

Septic Tank: 1000 Gallons; STB 358 Date 7-13-93

Pump Tank: — Gallons; PT — Date —

Nitrification Field: No Fields 1 Square Feet 690 Linear Feet 230'

No Lines 3 Trench Width 36" Trench Depth 36" Gravel Depth 12"

☑ New System ☐ Repair System Type: I. II. IV. V. VI

System Description: Conventional, gravity

Repair System Description: "

Maintenance Agreement Required: ☐ Yes ☑ No

☐ House/Mod. Home ☑ Mobile Home ☐ Business ☐ Other

No. Bedrooms 2 No. Bathrooms 2 No. Employees —

☐ Slab ☑ Crawl Space ☐ Basement w/plumbing ☐ Basement wo/plumbing

Garbage Disposal: ☐ Yes ☑ No


Auto. Dishwasher: ☑ Yes ☐ No

Auto. Washing Machine: ☑ Yes ☐ No


Other

Comments Keep Nitrification Lines on contour, Keep system 5' from foundation of home, 10' from all property lines, and 50' from any well. 100% Repair Area below system, conventional, gravity fed.

INITIAL SITE SKETCH

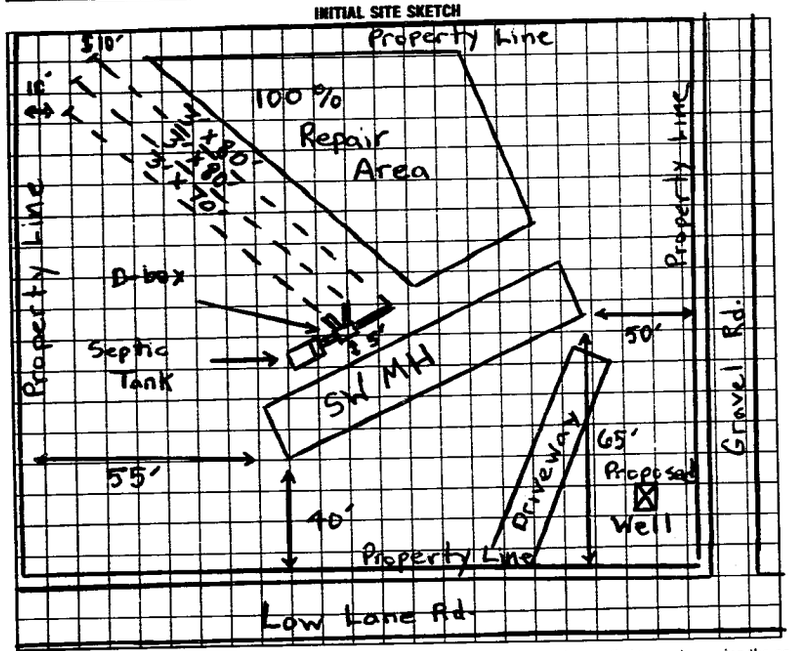

AS BUILT SKETCH

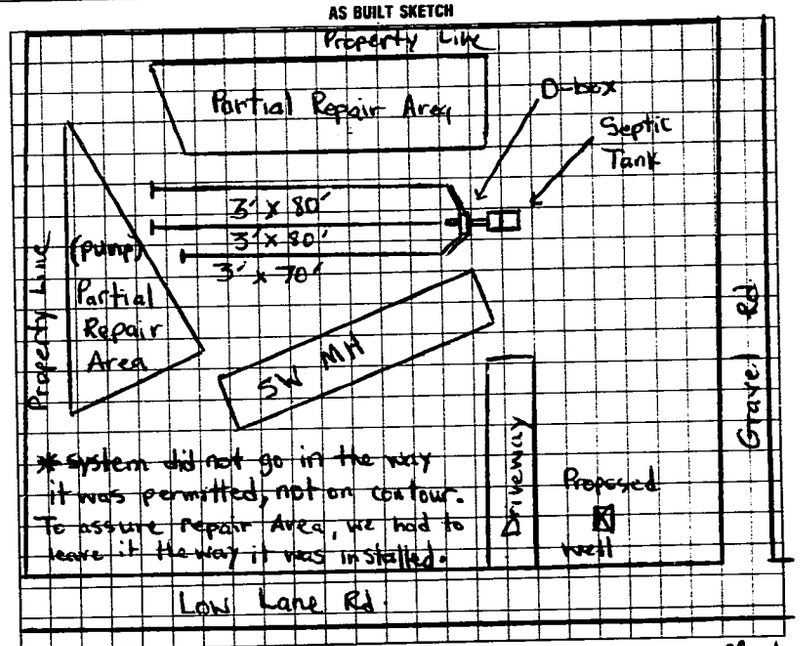

I understand that this permit can be suspended or revoked if any false information is supplied toward securing the permit/any unauthorized changes made to the site/any unauthorized changes are made in the installation of the system. Improvement Permit is valid for 60 months from date of issuance.

Signed: Audrey M. Owens

Improvement Permit by: Michael J. Dennis date 7-9-93

Existing System Inspection by: date

Installed by: Wayne Potts

Certificate of Completion by: Michael J. Dennis date 9-1-93

Operation Permit by: date

HEALTH DEPT. COPY: WHITE INSPECTION COPY (FINAL): GREEN OWNER COPY (FINAL): YELLOW INSPECTION COPY (INITIAL): PINK OWNER COPY (INITIAL): GOLD

* By the system not being on contour, it may affect the life span of system.