# IREDELL COUNTY HEALTH DEPARTMENT

STATESVILLE 704-878-5305 MOORESVILLE 704-664-5281

## IMPROVEMENT PERMIT / CERTIFICATE OF COMPLETION / OPERATION PERMIT / EXISTING SYSTEM INSPECTION

PROPERTY DESCRIPTION NO. 16603 DATE 7-13-93 TAX MAP NO. 3Q-6-A-15

OWNER OR CONTRACTOR Sunwood Builders PHONE: Business 872-0921 Home

ADDRESS Buffalo Shoals Road TR Enfola Rd TR Big Tree Toward end on Left

LOCATION

SUBDIVISION Woodland Acres BLOCK / SECTION LOT 15 LOT AREA 32201sq' SITE CLASS. PS L.T.A.R. .35 gal/sq'/day

Water Supply: ☑ Individual ☐ Community ☐ Public

Septic Tank: 1000 Gallons; STB 1012 Date 8-20-93

Pump Tank: — Gallons; PT — Date —

Nitrification Field: No. Fields 1 Square Feet 1035 Linear Feet 345

No. Lines 4 Trench Width 36 Trench Depth 24" Gravel Depth 12"

☑ New System ☐ Repair System Type: I. (II.) III. IV. V. VI

System Description: Conv. Gravity

Repair System Description:

Maintenance Agreement Required: ☐ Yes ☑ No

☐ House/Mod. Home No. Bedrooms 3

☑ Mobile Home No. Bathrooms 2

☐ Business No. Employees

☐ Other

☐ Slab ☑ Crawl Space ☐ Basement w/plumbing ☐ Basement wo/plumbing

Garbage Disposal: ☐ Yes ☑ No


Auto. Dishwasher: ☑ Yes ☐ No

Auto. Washing Machine: ☑ Yes ☐ No

Other

Comments Install shallow drainlines maximum 24"

**INITIAL SITE SKETCH**

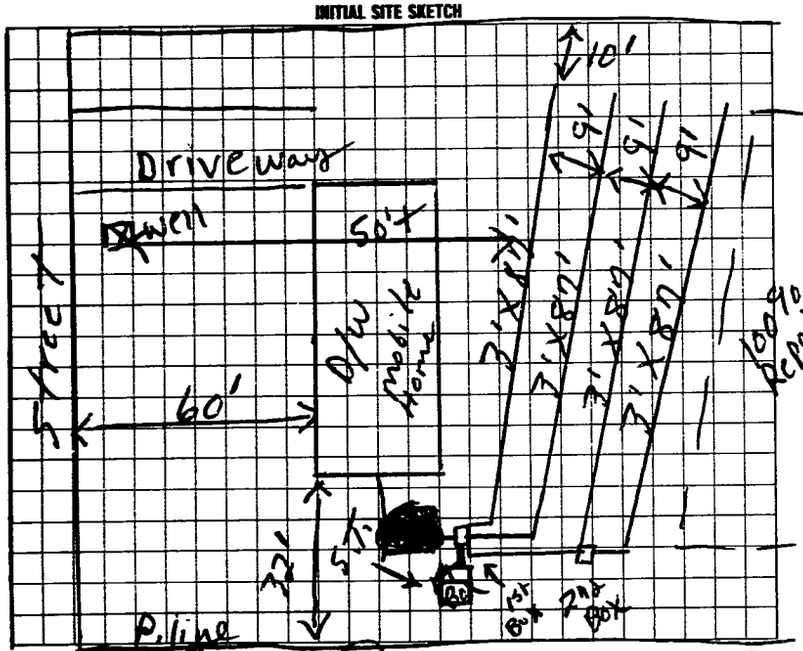


**AS BUILT SKETCH**

SAME AS INITIAL SKETCH

* Home not located at time of inspection Keep Home min. 5' from any part of septic system

I understand that this permit can be suspended or revoked if any false information is supplied toward securing the permit/any unauthorized changes are made to the site/any unauthorized changes are made in the installation of the system. Improvement Permit is valid for 60 months from date of issuance.

Signed: Terry W. Cook

Improvement Permit by: F. C. Moore date 7-13-93

Existing System Inspection by: date

Installed by: Tommy Cotheren

Certificate of Completion by: Michael J. Dennis date 11-2-93

Operation Permit by: date

HEALTH DEPT. COPY: WHITE INSPECTION COPY (FINAL): GREEN OWNER COPY (FINAL): YELLOW INSPECTION COPY (INITIAL): PINK OWNER COPY (INITIAL): GOLD