41078

IREDELL COUNTY HEALTH DEPARTMENT

STATESVILLE 704-878-5305 MOORESVILLE 704-664-5281

IMPROVEMENT PERMIT / CERTIFICATE OF COMPLETION / OPERATION PERMIT / EXISTING SYSTEM INSPECTION

PROPERTY DESCRIPTION NO. 16141 DATE 6-1-93 TAX MAP NO. 3Q-B-13

OWNER OR CONTRACTOR Sun-wood Builders PHONE: Business 872-0921 Home

ADDRESS

LOCATION I40W TL Old Mtn. Rd. TR Buffalo Shoals Rd TR Eufola, Rd. TR Big Tree Dr. 6th Lot on R

SUBDIVISION Woodland Acres BLOCK / SECTION LOT 6 LOT AREA 205' x 125' SITE CLASS. PS L.T.A.R. .35gpd/ft²

Water Supply: ☑ Individual ☐ Community ☐ Public Well

Septic Tank: 1000 Gallons; STB 358 Date 4-25-93

Pump Tank: — Gallons; PT — Date —

Nitrification Field: No Fields 1 Square Feet 1035 Linear Feet 345'

No Lines 3 Trench Width 36" Trench Depth 24"-30" Gravel Depth 12"

☑ New System ☐ Repair System Type: I. II. III. IV. V. VI

System Description: Conventional, gravity fed

Repair System Description:

Maintenance Agreement Required: ☐ Yes ☑ No

☐ House/Mod. Home ☑ Mobile Home ☐ Business ☐ Other

No. Bedrooms 3 (Septic Recms.) No. Bathrooms 2 No. Employees —

Garbage Disposal: ☐ Yes ☑ No

Auto. Dishwasher: ☑ Yes ☐ No


Auto. Washing Machine: ☑ Yes ☐ No

Other


☐ Slab ☑ Crawl Space ☐ Basement w/plumbing ☐ Basement wo/plumbing

Comments Keep MH min 5' from any part of septic system. Keep water supply line min. 10' from system. 100% Repair Area below system. conventional, gravity fed

INITIAL SITE SKETCH

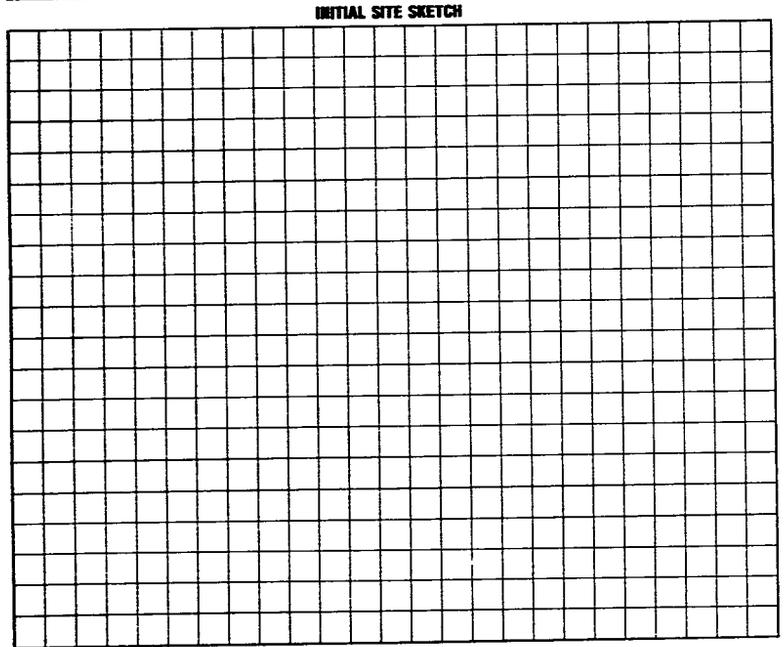

AS BUILT SKETCH

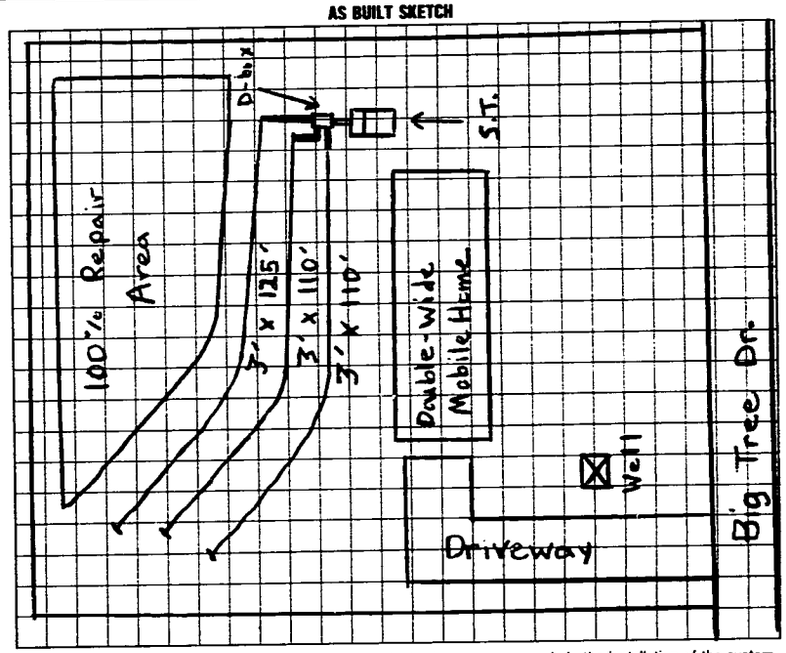

I understand that this permit can be suspended or revoked if any false information is supplied toward securing the permit/any unauthorized changes are made to the site/any unauthorized changes are made in the installation of the system. Improvement Permit is valid for 60 months from date of issuance.

Signed:

Improvement Permit by: Michael L. Dennis date 4-21-93

Existing System Inspection by: date

Installed by: A-1 Backhoe

Certificate of Completion by: Michael L. Dennis date 6-1-93

Operation Permit by: date

HEALTH DEPT. COPY: WHITE INSPECTION COPY (FINAL): GREEN OWNER COPY (FINAL): YELLOW INSPECTION COPY (INITIAL). PINK OWNER COPY (INITIAL): GOLD