48226

IREDELL COUNTY HEALTH DEPARTMENT

STATESVILLE 704-878-5305 MOORESVILLE 704-664-5281

IMPROVEMENT PERMIT / CERTIFICATE OF COMPLETION / OPERATION PERMIT / EXISTING SYSTEM INSPECTION

PROPERTY DESCRIPTION NO. 16594 DATE 7-7-93 TAX MAP NO. 3Q-6-A-9

OWNER OR CONTRACTOR Sunwest Builders PHONE: Business 872-0921 Home

ADDRESS PO Box 5477 Statesville

LOCATION Buffalo Shoals Rd TR Eupola Rd TR Big Tree Dr. 9th lot on Rt

SUBDIVISION Woodland Acres BLOCK / SECTION LOT 9 LOT AREA 1.898 acres SITE CLASS. P.S. L.T.A.R. .3

Water Supply: ☑ Individual ☐ Community ☐ Public

Septic Tank: 1000 Gallons; STB 1012 Date 5-14-93

Pump Tank: Gallons; PT Date

Nitrification Field: No Fields 1 Square Feet 1200 Linear Feet 400

No Lines 3 Trench Width 36 Trench Depth 24 Gravel Depth 12

☑ New System ☐ Repair System Type: I, II, III, IV, V, VI

System Description: Conv. Gravity

Repair System Description: Partial Remainder pump to septic liner

Maintenance Agreement Required: ☐ Yes ☑ No

☐ House/Mod. Home ☑ Mobile Home ☐ Business ☐ Other

No. Bedrooms 3 No. Bathrooms 2 No. Employees

☐ Slab ☑ Crawl Space ☐ Basement w/plumbing

Garbage Disposal: ☐ Yes ☑ No

Auto. Dishwasher: ☑ Yes ☐ No


Auto. Washing Machine: ☑ Yes ☐ No

Other

☐ Basement wo/plumbing

Comments Install System Shallow No deeper than 24" deep

INITIAL SITE SKETCH

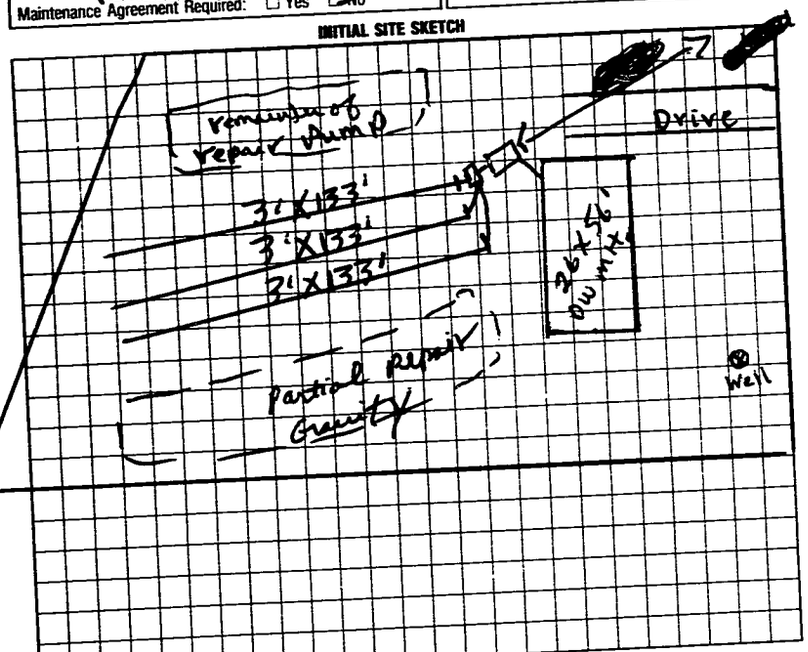

AS BUILT SKETCH

SAME AS INITIAL SKETCH

I understand that this permit can be suspended or revoked if any false information is supplied toward securing the permit/any unauthorized changes are made to the site/any unauthorized changes are made in the installation of the system. Improvement Permit is valid for 60 months from date of issuance.

Signed: [signature] date 7-7-93

Improvement Permit by: P.C. Moore date

Existing System Inspection by: date

Installed by: Tommy Cotheren

Certificate of Completion by: Michael P. Dennis date 5-16-93

Operation Permit by: date

HEALTH DEPT. COPY: WHITE INSPECTION COPY (FINAL): GREEN OWNER COPY (FINAL): YELLOW INSPECTION COPY (INITIAL): PINK OWNER COPY (INITIAL): GOLD