# IREDELL COUNTY HEALTH DEPARTMENT

STATESVILLE 704-878-5305 MOORESVILLE 704-664-5281

## IMPROVEMENT PERMIT / CERTIFICATE OF COMPLETION / OPERATION PERMIT / EXISTING SYSTEM INSPECTION

PROPERTY DESCRIPTION NO. 1880 DATE 8-4-94 TAX MAP NO. 3Q-6-A-21 Watershed: ☐ Yes ☒ No

OWNER OR CONTRACTOR Sunwood Builders PHONE: Business 872-0921 Home

ADDRESS 212 Newton Drive

LOCATION Buffalo Shoales Rd TR Eufola Rd TR Big Tree 1/3 mi on left

SUBDIVISION Woodland acres BLOCK / SECTION 2 LOT 21 LOT AREA 1.93 acres SITE CLASS. PSC DESIGN FLOW 360 L.T.A.R. .35

Septic Tank: 1000 Gallons; STB 1012 Date 8-2-94

Pump Tank: Gallons; PT Date

Pump Make: Model Serial No.

Nitrification Field: No Fields 1 Square Feet 1035 Linear Feet 345

No Lines 3 Trench Width 36" Max Trench Bottom Depth 36" Gravel Depth 12"

☒ New System ☐ Repair System Type: I, II, III, IV, V, VI

System Description: Conv. Gravity

Repair System Description: " "

Maintenance Agreement Required: ☐ Yes ☒ No

☐ House/Mod. Home ☒ Mobile Home ☐ Business ☐ Other

No. Bedrooms 3 No. Bathrooms 2 No. Employees


☐ Slab ☒ Crawl Space ☐ Basement w/plumbing ☐ Basement wo/plumbing

Water Supply: ☒ Individual ☐ Community ☐ Public

Comments:

Comments: Home and well not located at time of inspection. Keep foundation of home min 5' from system. Keep well min. 50' from any septic system. 100% Repair below system. Conventional + gravity fed.

INITIAL SITE SKETCH

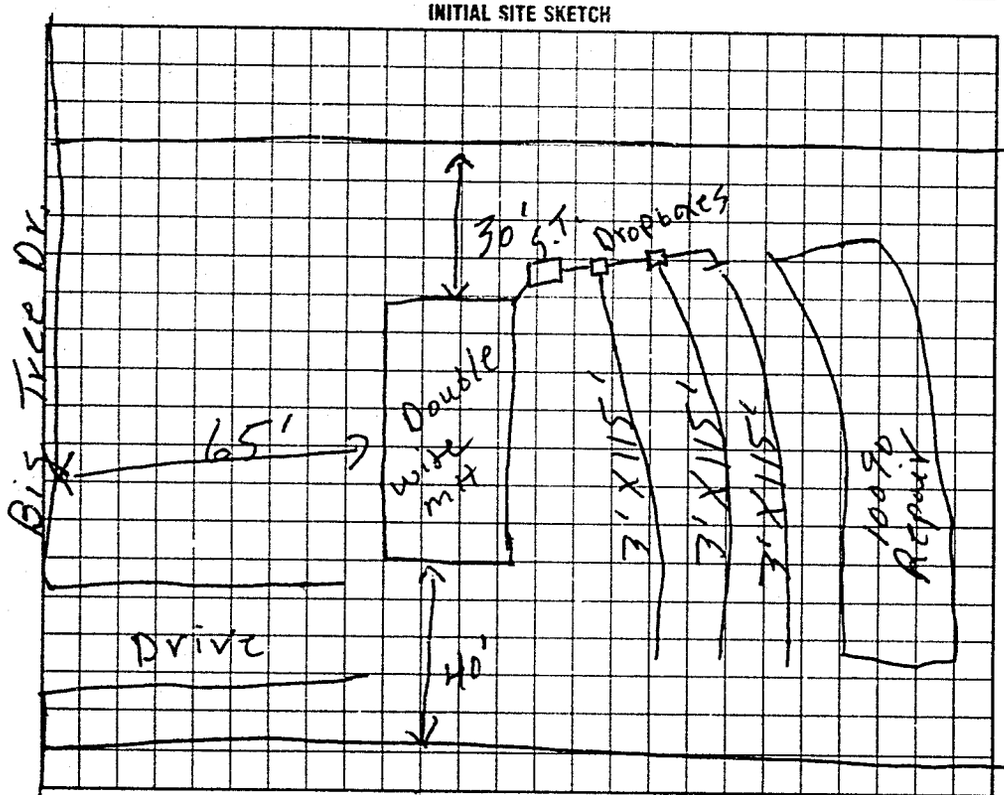


AS BUILT SKETCH

SAME AS INITIAL SKETCH

I understand that this permit can be suspended or revoked if any false information is supplied toward securing the permit/any unauthorized changes are made to the site/any unauthorized changes are made in the installation of the system. Improvement Permit is valid for 60 months from date of issuance.

Signed: X David Schulach

Improvement Permit by: L. C. Moore date 8-4-94

Existing System Inspection by: date

Installed by: Tommy Cothren

Certificate of Completion by: Michael Q. Owens date 11-1-94

Operation Permit by: date

HEALTH DEPT COPY: WHITE INSPECTION COPY (FINAL): GREEN OWNER COPY (FINAL): YELLOW INSPECTION COPY (INITIAL): PINK OWNER COPY (INITIAL): GOLD