IREDELL COUNTY HEALTH DEPARTMENT

Jenkins Williams

STATESVILLE 704-878-5305 MOORESVILLE 704-664-5281

IMPROVEMENT PERMIT / CERTIFICATE OF COMPLETION / OPERATION PERMIT / EXISTING SYSTEM INSPECTION

PROPERTY DESCRIPTION NO. 20043 DATE 1-12-95 TAX MAP NO. 3Q-6-A-19 Watershed: ☑ Yes ☐ No

OWNER OR CONTRACTOR Sunwood Builders PHONE: Business Home (872-0922) WS IV-PA

ADDRESS 2112 Newton Dr. Statesville

LOCATION Buffalo Shoals TR Enfola Rd TR Bee Tree 1/4 mi L

SUBDIVISION Woodlands Acres BLOCK / SECTION LOT 19 LOT AREA .93 acres SITE CLASS. PS DESIGN FLOW 360 L.T.A.R. .35

Septic Tank: 1000 Gallons; STB 1012 Date 11-3-94

Pump Tank: — Gallons; PT — Date —

Pump Make: — Model — Serial No. —

Nitrification Field: No Fields 1 Square Feet 1050 Linear Feet 350

No Lines 5 Trench Width 36" Max Trench Bottom Depth 36" Gravel Depth 12"

☐ New System ☐ Repair System Type: I, II, III, IV, V, VI

System Description: Conv. Gravity

Repair System Description: "

Maintenance Agreement Required: ☐ Yes ☑ No

☑ House/Mod. Home No. Bedrooms 3

☐ Mobile Home No. Bathrooms 2

☐ Business No. Employees

☐ Other


☐ Slab ☑ Crawl Space ☐ Basement w/plumbing ☐ Basement wo/plumbing

Water Supply: ☑ Individual ☐ Community ☐ Public

Comments:

Comments: Home and well not located at time of Inspection. Keep both required distances from the septic system.

INITIAL SITE SKETCH 230'

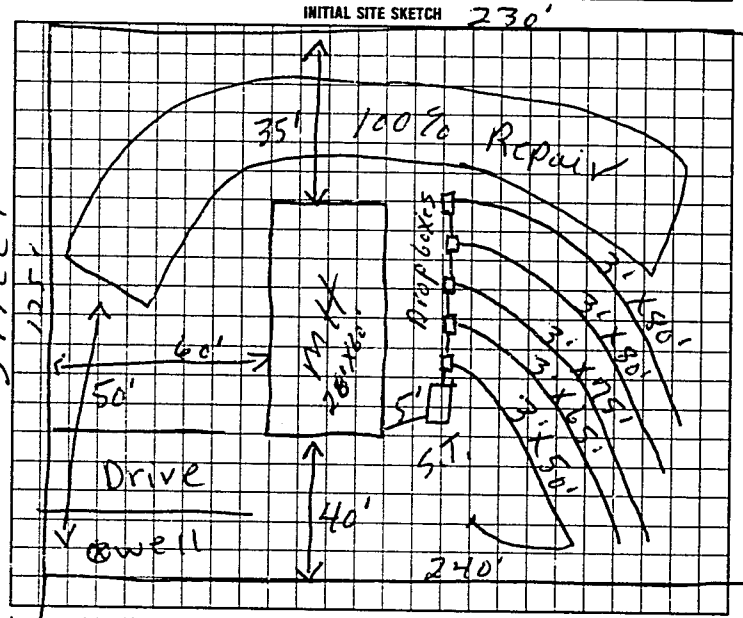

AS BUILT SKETCH

SAME AS INITIAL SKETCH

I understand that this permit can be suspended or revoked if any false information is supplied toward securing the permit/any unauthorized changes are made to the site/any unauthorized changes are made in the installation of the system. Improvement Permit is valid for 60 months from date of issuance.

Signed: X

Improvement Permit by: R. C. Moore date 1-12-95

Existing System Inspection by: R. Michael Hoge date 1-12-95

Installed by: Tommy Cathren

Certificate of Completion by: Michael J. Quinn date 2-2-95

Operation Permit by: date

HEALTH DEPT. COPY: WHITE INSPECTION COPY (FINAL): GREEN OWNER COPY (FINAL): YELLOW INSPECTION COPY (INITIAL): PINK OWNER COPY (INITIAL): GOLD

296100