IREDELL COUNTY HEALTH DEPARTMENT

STATESVILLE 704-878-5305 MOORESVILLE 704-664-5281

56939

IMPROVEMENT PERMIT / CERTIFICATE OF COMPLETION / OPERATION PERMIT / EXISTING SYSTEM INSPECTION

PROPERTY DESCRIPTION NO. 20041 DATE 4-3-95 TAX MAP NO. 3Q-6-A-17 Watershed: ☐ Yes ☑ No

OWNER OR CONTRACTOR Sun Wood Bldrs. PHONE: Business 872-0922 Home

ADDRESS 2112 Newton Dr. Statesville, N.C. 28677

LOCATION I40W TL old Mtn. Rd. TR Buffalo Shoals Rd TR Eufola Rd. TR Big Tree Drive Lot on L in new section

SUBDIVISION Woodland Acres BLOCK / SECTION LOT 17 & 18 LOT AREA ~1.0 acre SITE CLASS. P.S. DESIGN FLOW 360 L.T.A.R. .3gpd/ft²

Septic Tank: 1000 Gallons; STB — Date —

Pump Tank: — Gallons; PT — Date —

Pump Make: — Model — Serial No. —

Nitrification Field: No Fields 1 Square Feet *Equivalent to 1360 Linear Feet 300'

No Lines 5 Trench Width 36" Max Trench Bottom Depth 24"

☑ New System ☐ Repair System Type: I, II, III, IV, V, VI

System Description: Chambered Graveless System

Repair System Description: " "

Maintenance Agreement Required: ☐ Yes ☑ No

☐ House/Mod. Home No. Bedrooms 3

☑ Mobile Home No. Bathrooms 2

☐ Business No. Employees

☐ Other


Gravel Depth NA ☐ Slab ☑ Crawl Space ☐ Basement w/plumbing ☐ Basement wo/plumbing

Water Supply: ☑ Individual ☐ Community ☐ Public

Comments: INSTALL SYSTEM SHALLOW (no deeper than 24" on lower side of trench wall) Keep lines on contour Keep system 5' from property lines, 5' from foundation of home, and max. feasible distance from any well and no closer than 50'. Create surface diversion ditch around system to route surface water around

Comments: Well not located at time of inspection. Keep it max. feasible distance from septic system and no closer than 50'. Inspected system on 8-4-95. Inspected surface diversion ditch on 8-7-95.

INITIAL SITE SKETCH

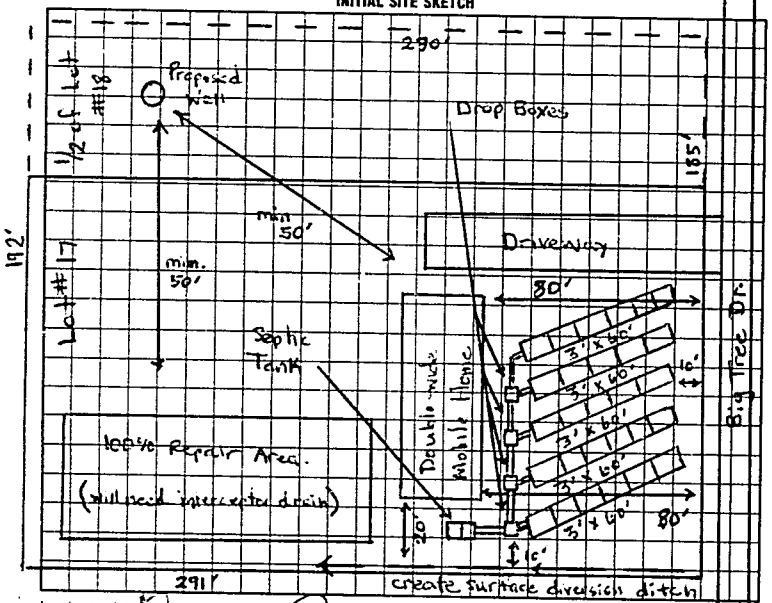

AS BUILT SKETCH

System: 100% Repair Area behind home, gravity fed infiltrator.

Bring in enough sand to fill around vents in chambers.

Surface diversion ditch installed very crudely. Recommend that when final landscaping done, that the ditch be a little better defined. Ditch as is will be effective but may fill up very quickly

SAME AS INITIAL SKETCH

I understand that this permit can be suspended or revoked if any false information is supplied toward securing the permit/any unauthorized changes are made to the site/any unauthorized changes are made in the installation of the system. Improvement permit is valid for 60 months from date of issuance.

Signed: Jerry W Jaspen

Improvement Permit by: Michael J Dennis date 6-23-95

Existing System Inspection by: date

Installed by: Tommy Cothren

Certificate of Completion by: date

Operation Permit by: Michael J Dennis date 8-7-95

HEALTH DEPT COPY WHITE INSPECTION COPY (FINAL) GREEN OWNER COPY (FINAL) YELLOW INSPECTION COPY (INITIAL) PINK OWNER COPY (INITIAL) GOLD