20652 Not on Comp

IREDELL COUNTY HEALTH DEPARTMENT

STATESVILLE 704-878-5305 MOORESVILLE 704-664-5281

IMPROVEMENT PERMIT / CERTIFICATE OF COMPLETION / OPERATION PERMIT / EXISTING SYSTEM INSPECTION

PROPERTY DESCRIPTION NO. 18747 DATE 3-21-95 TAX MAP NO. 3Q-6-A-33 Watershed: ☐ Yes ☑ No

OWNER OR CONTRACTOR Sun Wood Bldrs. PHONE: Business Home 872-0922

ADDRESS 2112 Newton Dr. Statesville, N.C. 28677

LOCATION I-40W TL Old Mtn. Rd TR Buffalo Shoals Rd TR Eufola Rd. TR Big Tree Dr. 4th lot on R in New Section

SUBDIVISION Woodland Acres BLOCK / SECTION 2 LOT 33 LOT AREA ± .75 acre SITE CLASS. P.S. DESIGN FLOW 360 L.T.A.R. .3 gpd/ft²

Septic Tank: 1000 Gallons; STB 1612 Date 1-22-95

Pump Tank: — Gallons; PT — Date —

Pump Make: — Model — Serial No. —

Nitrification Field: No Fields 1 Square Feet 1200 Linear Feet 400'

No Lines 3 Trench Width 36" Max Trench Bottom Depth 18-22" Gravel Depth 12"

☑ New System ☐ Repair System Type: I, II, III, IV, V, VI

System Description: conventional, gravity fed

Repair System Description: " "

Maintenance Agreement Required: ☐ Yes ☑ No

☐ House/Mod. Home ☑ Mobile Home ☐ Business ☐ Other

No. Bedrooms 3 No. Bathrooms 2 No. Employees —


☐ Slab ☑ Crawl Space ☐ Basement w/plumbing ☐ Basement wo/plumbing

Water Supply: ☑ Individual ☐ Community ☐ Public

Comments: INSTALL SYSTEM SHALLOW (no deeper than 18" to trench bottom on lower side of trench.) Keep lines and trenches on contour. Keep system 5' from foundation of home, 10' from all Property lines, 10' from Interceptor drain, and max. feasible distance from well and no closer than 50'. Install interceptor drain.

Comments:

INITIAL SITE SKETCH

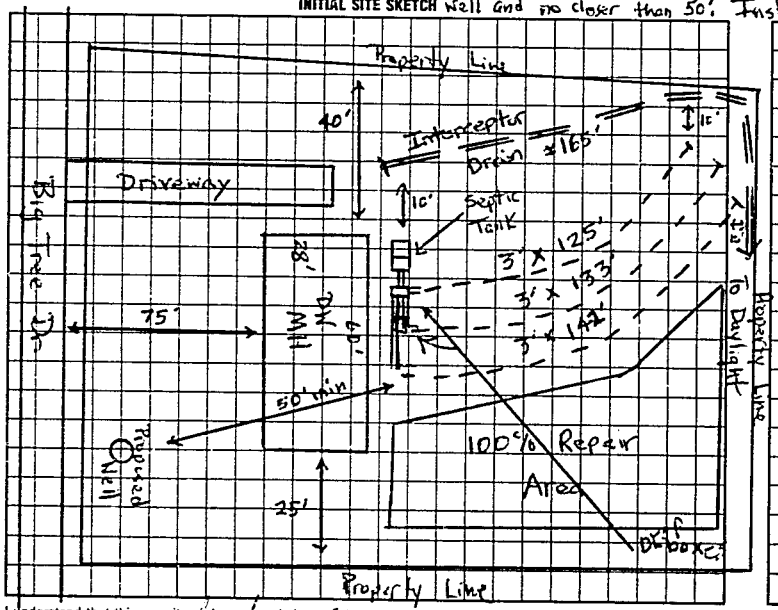

AS BUILT SKETCH

around Septic System, min 4' deep, 6" wide, ≈165' in length, and fill with gravel and slotted pipe up to 6" to surface.

100% Repair Area below system, conventional gravity fed.

Call for an Inspection of interceptor drain before installing pipe and gravel.

Same as initial Sketch

I understand that this permit can be suspended or revoked if any false information is supplied toward securing the permit/any unauthorized changes are made to the site/any unauthorized changes are made in the installation of the system. Improvement Permit is valid for 60 months from date of issuance.

Signed:

Improvement Permit by: Michael Dennis date 3-21-95

Existing System Inspection by: date

Installed by: Tommy Cothren

Certificate of Completion by: B. C. Moore date 3-24-95

Operation Permit by: date

HEALTH DEPT. COPY: WHITE INSPECTION COPY (FINAL): GREEN OWNER COPY (FINAL): YELLOW INSPECTION COPY (INITIAL): PINK OWNER COPY (INITIAL): GOLD

256100