IREDELL COUNTY HEALTH DEPARTMENT

31-6-A-32 on Comp.

STATESVILLE 704-878-5305 MOORESVILLE 704-664-5281

IMPROVEMENT PERMIT / CERTIFICATE OF COMPLETION / OPERATION PERMIT / EXISTING SYSTEM INSPECTION

PROPERTY DESCRIPTION NO. 18748 DATE 7-26-94 TAX MAP NO. 3Q-6-A-32

OWNER OR CONTRACTOR Sun-Wood Builders PHONE: Business Home 872-0921 Watershed: ☐ Yes ☑ No

ADDRESS 2112 Newton Dr. Sta.

LOCATION Buffalo Shoales Rd TR Enfola Rd TR Big Tree Dr. 1/4mi Rd

SUBDIVISION Woodland Acres BLOCK / SECTION LOT 32 LOT AREA 125X250 SITE CLASS. PS DESIGN FLOW 360 L.T.A.R. .3

Septic Tank: 1000 Gallons; STB Date

Pump Tank: Gallons; PT Date

Pump Make: Model Serial No.

Nitrification Field: No Fields 1 Square Feet 1200 Linear Feet 400

No Lines 3 Trench Width 36" Max Trench Bottom Depth 24" Gravel Depth 12"

☑ New System ☐ Repair System Type: I, II, III, IV, V, VI

System Description: Conv. Gravity

Repair System Description:

Maintenance Agreement Required: ☐ Yes ☑ No

☐ House/Mod. Home No. Bedrooms 3

☑ Mobile Home No. Bathrooms 2

☐ Business No. Employees

☐ Other


☐ Slab ☐ Crawl Space ☐ Basement w/plumbing ☐ Basement wo/plumbing

Water Supply: ☑ Individual ☐ Community ☐ Public


Comments: Run Drain lines on contour No Deeper than 24" Due to Shallow Soil Depths this is critical

Comments:

INITIAL SITE SKETCH

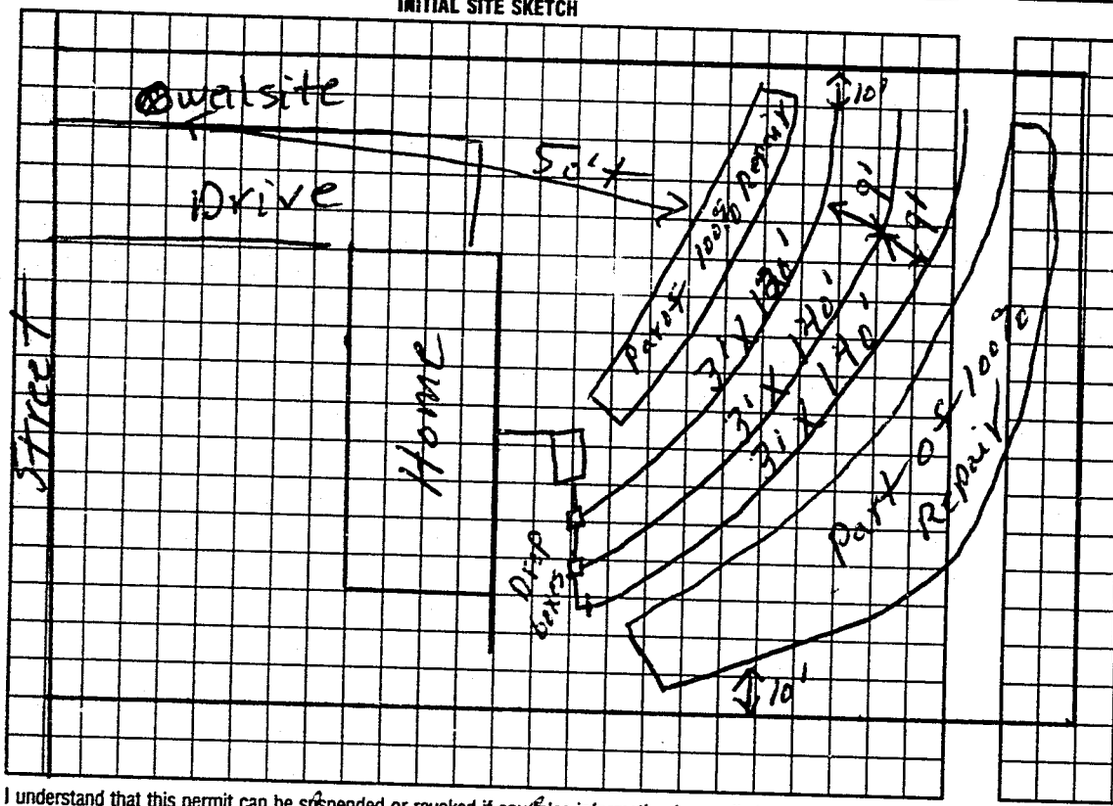

AS BUILT SKETCH

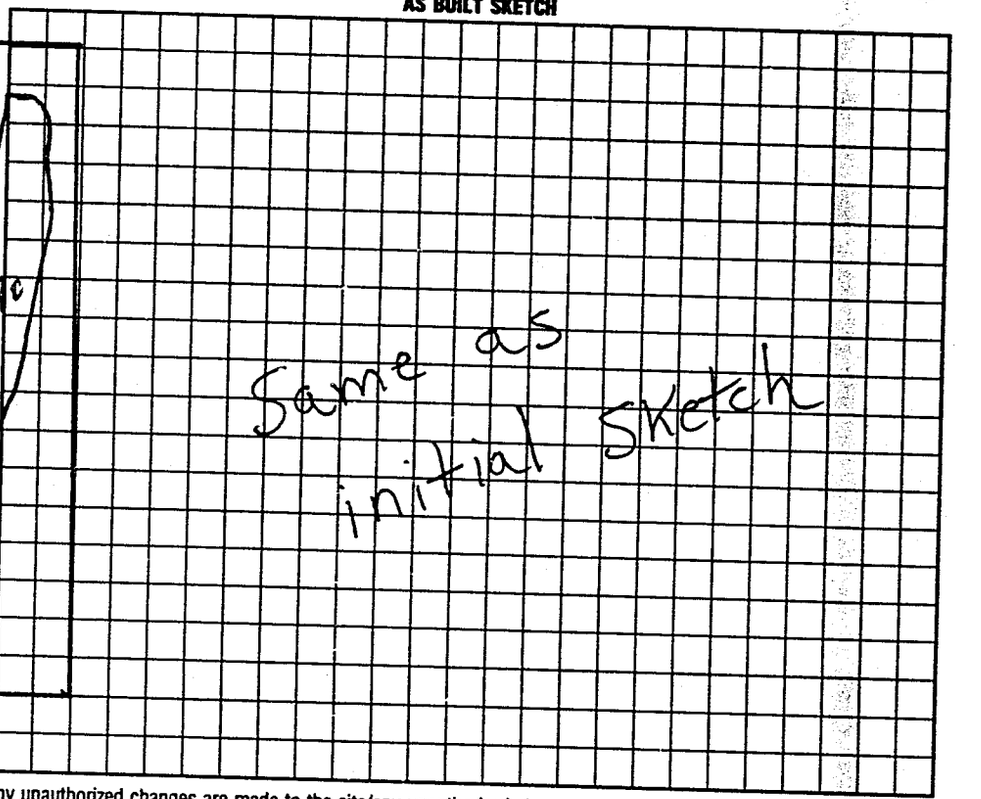

I understand that this permit can be suspended or revoked if any false information is supplied toward securing the permit/any unauthorized changes are made to the site/any unauthorized changes are made in the installation of the system. Improvement Permit is valid for 60 months from date of issuance.

Signed: David Blankenship

Improvement Permit by: L.C. Moore date 7-26-94

Existing System Inspection by: date

Installed by: A-1 Backhoe

Certificate of Completion by: L.C. Moore date 8-2-94

Operation Permit by: date

HEALTH DEPT COPY: WHITE INSPECTION COPY (FINAL): GREEN OWNER COPY (FINAL): YELLOW INSPECTION COPY (INITIAL): PINK OWNER COPY (INITIAL): GOLD