IREDELL COUNTY HEALTH DEPARTMENT

STATESVILLE 704-878-5305 MOORESVILLE 704-664-5281

IMPROVEMENT PERMIT / CERTIFICATE OF COMPLETION / OPERATION PERMIT / EXISTING SYSTEM INSPECTION

PROPERTY DESCRIPTION NO. 065879 DATE 4-22-97 TAX MAP NO. Pin No. 4712648811 Watershed: ☐ Yes ☐ No

OWNER OR CONTRACTOR Sunwood Builders PHONE: Business 704-872-0922 Home

ADDRESS PO Box 5877 Statesville WSIV-PA

LOCATION Buffalo Shoals TR Buffalo TR Big Tree TR Gloria Brook 3rd lot left

SUBDIVISION Woodland Acres BLOCK / SECTION LOT 39 LOT AREA 1.75 acres SITE CLASS. PS DESIGN FLOW 360 L.T.A.R. 13

Septic Tank: 1000 Gallons; STB Date

Pump Tank: Gallons; PT Date

Pump Make: Model Serial No.

Nitrification Field: No. Fields 1 Square Feet 1200 Linear Feet 400

No. Lines 4 Trench Width 36" Max Trench Bottom Depth 36" Gravel Depth 12"

☑ New System ☐ Repair System Type: I II III IV V VI

System Description: Conv. Gravity

Repair System Description: Gravity Chambers

Maintenance Agreement Required: ☐ Yes ☑ No

☐ House/Mod. Home ☐ Mobile Home ☐ Business ☐ Other

No. Bedrooms 3 No. Bathrooms 2 No. Employees

☐ Slab ☐ Crawl Space ☐ Basement w/plumbing ☐ Basement wo/plumbing


Water Supply: ☑ Individual ☐ Community ☐ Public

Comments:


Comments:

White Division Switched, Tank Not marked didn't get Feed Lines

INITIAL SITE SKETCH

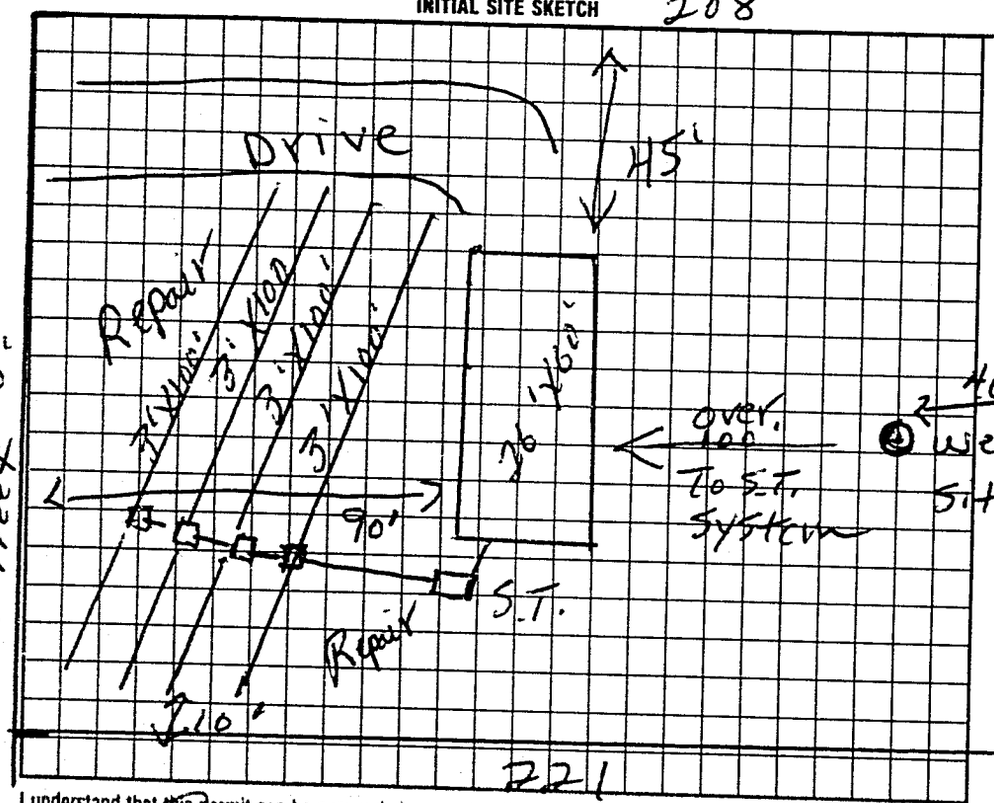

AS BUILT SKETCH

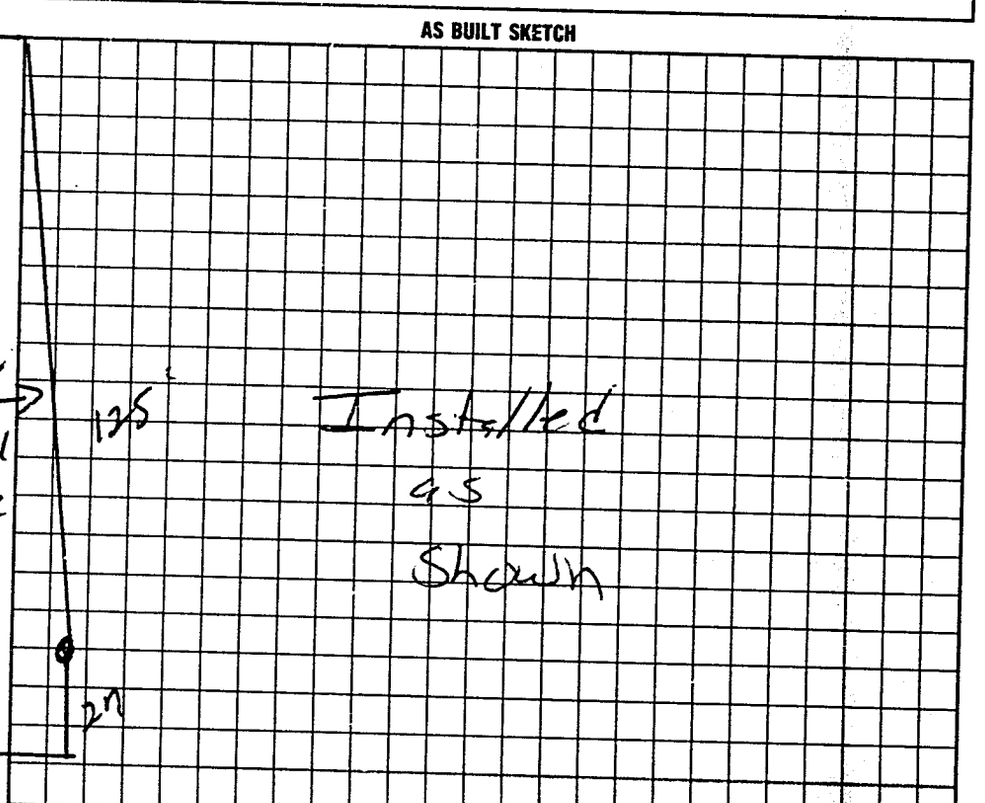

I understand that this permit can be suspended or revoked if any false information is supplied toward securing the permit/any unauthorized changes are made to the site/any unauthorized changes are made in the installation of the system. Improvement Permit is valid for 60 months from date of issuance.

Signed:

Improvement Permit by: L.C. Moore date 4-22-97

Authorization

Existing System Inspection by: L.C. Moore date 4-22-97

to cont.

Installed by: Tommy Cothern

Certificate of Completion by: date

Operation Permit by: Mark Cox date 3-5-98

HEALTH DEPT. COPY: WHITE INSPECTION COPY (FINAL): GREEN OWNER COPY (FINAL): YELLOW INSPECTION COPY (INITIAL): PINK OWNER COPY (INITIAL): GOLD

Authorization to cont. Expires 60 mos from issue