IREDELL COUNTY HEALTH DEPARTMENT

STATESVILLE 704-878-5305 MOORESVILLE 704-664-5281

IMPROVEMENT PERMIT / CERTIFICATE OF COMPLETION / OPERATION PERMIT / EXISTING SYSTEM INSPECTION

PROPERTY DESCRIPTION NO. 065889 DATE 4-22-97 TAX MAP NO. Pin No. 4712658811 Watershed: ☐ Yes ☐ No

OWNER OR CONTRACTOR Sunwood Builders PHONE: Business 872 0922 Home

ADDRESS PO Box 5277 Sta

LOCATION Buffalo Shoals Turn Eufola TR Big Tree TR Gloria Brook 4th lot L side

SUBDIVISION Woodland Acres BLOCK / SECTION LOT 40 LOT AREA 1.73 acr SITE CLASS P3 DESIGN FLOW 340 L.T.A.R. .13

Septic Tank: 1000 Gallons; STB 1012 Date 11-12-97

Pump Tank: Gallons; PT Date

Pump Make: Model Serial No.

Nitrification Field: No Fields 1 Square Feet 1200 Linear Feet 400

No Lines 4 Trench Width 36" Max Trench Bottom Depth 36" Gravel Depth 12"

☐ New System ☐ Repair System Type: I II III IV V VI

System Description: Conv. Gravity

Repair System Description:

Maintenance Agreement Required: ☐ Yes ☐ No

☐ House/Mod. Home ☐ Mobile Home ☐ Business ☐ Other

No. Bedrooms 3 No. Bathrooms 2 No. Employees

Water Supply: ☐ Individual ☐ Community ☐ Public


☐ Slab ☐ Crawl Space ☐ Basement w/plumbing ☐ Basement wo/plumbing

Comments:


Comments:

* Note Lines Not split feed
House shifted over closer to PL
Tank 15ft off PL

INITIAL SITE SKETCH

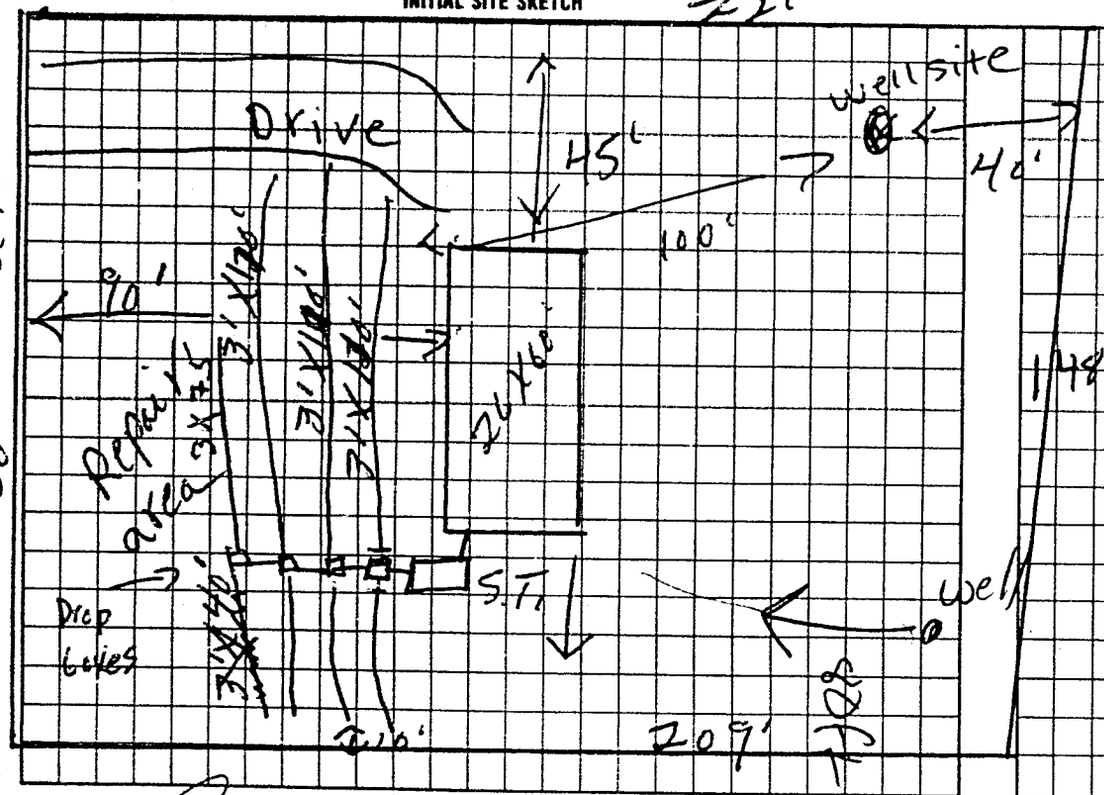

AS BUILT SKETCH

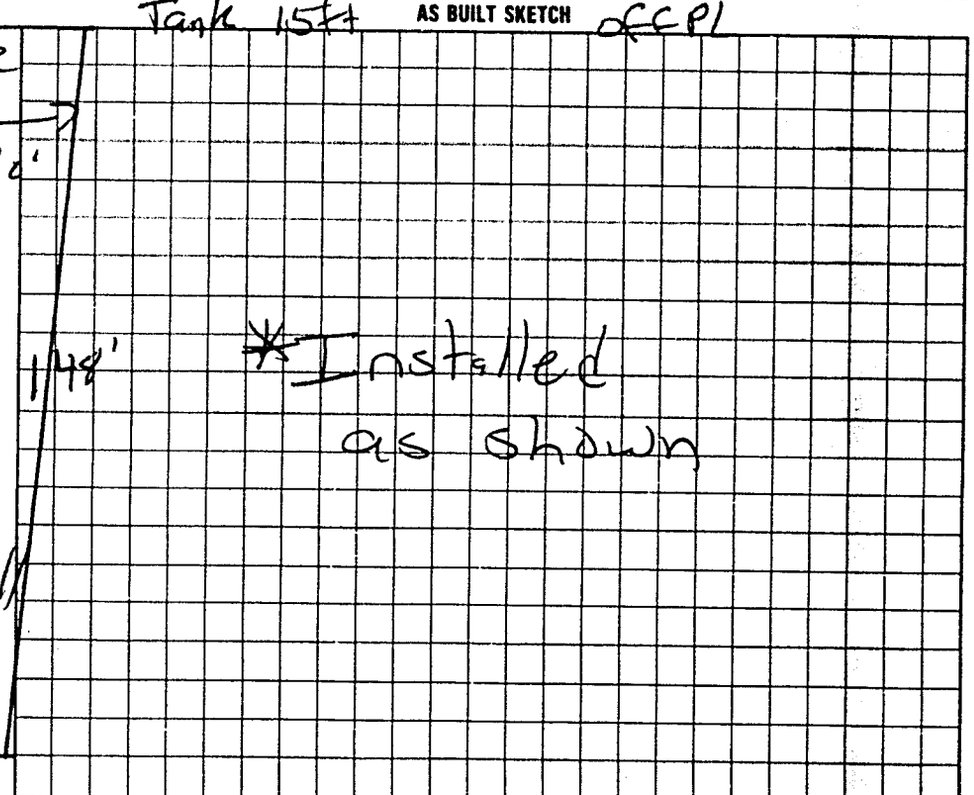

I understand that this permit can be suspended or revoked if any false information is supplied toward securing the permit/any unauthorized changes are made to the site/any unauthorized changes are made in the installation of the system.

Signed: Terry W Jenkins

Improvement Permit by: P.C. Moore date 4-22-97

Existing System Inspection by: P.C. Moore date 4-22-98

Installed by: Tommy Cothern

Certificate of Completion by: date

Operation Permit by Mark Conners date 2-26-98

HEALTH DEPT COPY: WHITE INSPECTION COPY (FINAL): GREEN OWNER COPY (FINAL): YELLOW INSPECTION COPY (INITIAL): PINK OWNER COPY (INITIAL): GOLD

to cc int.

Authorization to Count. Expires 60 mos from issue