IREDELL COUNTY HEALTH DEPARTMENT

STATESVILLE 704-878-5305 MOORESVILLE 704-664-5281

IMPROVEMENT PERMIT / AUTHORIZATION TO CONSTRUCT / OPERATION PERMIT / EXISTING SYSTEM INSPECTION

PERMIT# 076802 PIN# 4712 64 9509 DATE 10-20-98

OWNER OR CONTRACTOR WAYNE C. JENKINS PHONE: Business 872-0921 Home

ADDRESS P.O. Box 5877, STATESVILLE, NC 28687

LOCATION BUFFALO SHOALS ROAD, TR EUTOCA, TR BIG TREE, TR GLORIA BROOK, 1st LOT ON RIGHT

SUBDIVISION WOODLAND ACRES BLOCK / SECTION LOT 43 LOT AREA 2.12 ACRES± SITE CLASS PS DESIGN FLOW 360 L.T.A.R. 0.25 GPD/FT²

Septic Tank: 1000 Gallons; STB 1007 Date

Pump Tank: Gallons; PT Date

Pump Make: Model Serial No.

Nitrification Field: No Fields 1 Square Feet EQ. 1440 Linear Feet B 360+

No Lines SIX Trench Width 36" Max Trench Bottom Depth 36" Gravel Depth SAND 6"

☑ New System ☐ Repair System Type: I, II, (III) IV, V, VI

System Description: CHAMBERED GRAVITY

Repair System Description: LOW PRESSURE PIPE

Maintenance Agreement Required: ☐ Yes ☑ No

☐ House/Mod. Home No. Bedrooms 3

☐ Mobile Home No. Bathrooms 2

☐ Business No. Employees

☐ Other

☐ Slab ☑ Crawl Space ☐ Basement w/plumbing ☐ Basement wo/plumbing


Water Supply: ☑ Individual ☐ Public ☐ Community

WELL


Comments:/Conditions: ① INSTALL SIXTY CHAMBERS (OWNERS REQUEST) IN SIX EQUAL LENGTH LINES ON CONTOUR AS SHOWN ② USE ONE FLOW DIVIDER TEE TO ACHIEVE EQUAL DISTRIBUTION INTO TWO SERIES OF DROP BOXES FEEDING THREE LINES EACH

Comments:/Conditions:

INITIAL SITE SKETCH SCALE: 1" = 50'

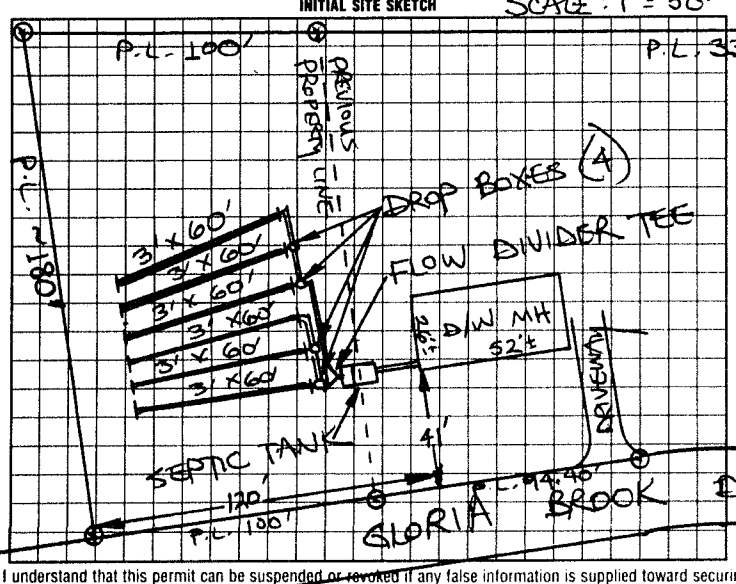

AS BUILT SKETCH

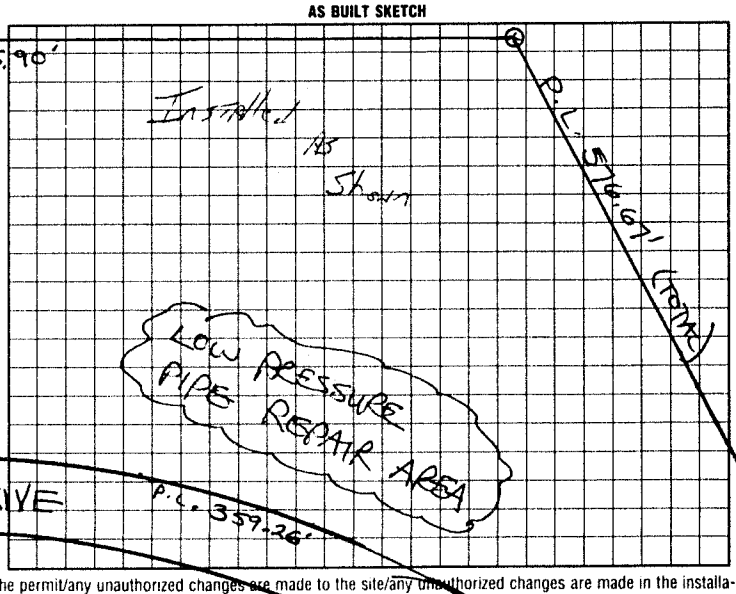

I understand that this permit can be suspended or revoked if any false information is supplied toward securing the permit/any unauthorized changes are made to the site/any unauthorized changes are made in the installation of the system. Improvement Permit with plat valid without expiration. Improvement Permit with site plan valid for sixty months. Authorization to Construct is valid for a period equal to that of Improvement Permit – not to exceed sixty months.

Signed: Wayne W Jenkins date

Improvement Permit by: STEVE HEDRICK date 10-20-98

Authorization to Construct by: STEVE HEDRICK date 10-20-98

Installed by: Tommy Cothren

Operation Permit by: L Potter date OCT 5 99

Existing System Inspection by: date

HEALTH DEPT. COPY: WHITE INSPECTION COPY (FINAL) GREEN OWNER COPY (FINAL) YELLOW INSPECTION COPY (INITIAL) PINK OWNER COPY (INITIAL) GOLD