IREDELL COUNTY HEALTH DEPARTMENT

STATESVILLE 704-878-5305 MOORESVILLE 704-664-5281

IMPROVEMENT PERMIT / CERTIFICATE OF COMPLETION / OPERATION PERMIT / EXISTING SYSTEM INSPECTION

PROPERTY DESCRIPTION NO. 19659 PARCEL 3Q-6-A-25 ← TAX MAP NO. DATE 11-1-94 Watershed: ☐ Yes ☑ No

OWNER OR CONTRACTOR Sun-Wood Bldrs. PHONE: Business Home 872-0921

ADDRESS 2112 Newton Dr., Statesville, N.C. 28677

LOCATION I-40W TL Old Mtn. TR Buffalo Shoals TR Eufola Rd. TR Big Tree Dr. Lot near end on L.

SUBDIVISION Woodland Acres BLOCK / SECTION 2 LOT 25 LOT AREA 1.09 acres SITE CLASS. P.S. DESIGN FLOW 360 L.T.A.R. 3gpd/ft2

Septic Tank: 1000 Gallons; STB 1012 Date 9-18-94

Pump Tank: — Gallons; PT — Date —

Pump Make: — Model — Serial No. —

Nitrification Field: No Fields 1 Square Feet 1200 Linear Feet 400'

No Lines 4 Trench Width 36" Max Trench Bottom Depth 24 Gravel Depth 12"

☑ New System ☐ Repair System Type: I, II, III, IV, V, VI

System Description: Conventional, gravity fed

Repair System Description: "

Maintenance Agreement Required: ☐ Yes ☑ No

☐ House/Mod. Home No. Bedrooms 3

☑ Mobile Home No. Bathrooms 2

☐ Business No. Employees —

☐ Other —


☐ Slab ☑ Crawl Space ☐ Basement w/plumbing ☐ Basement wo/plumbing

Water Supply: ☑ Individual ☐ Community ☐ Public

Comments: INSTALL SYSTEM SHALLOW (no deeper than 24" to trench bottom) Keep lines and trenches on contour. Keep System min. 5' from foundation, 10' from all property lines, and 50' from any well. 100% Repair Area below system conventional, gravity fed.

Comments: Home and well not located at time of inspection. Keep home min. 5' from any part of septic system. [redacted] Keep well min. 50' from any part of any septic system. 100% Repair below system, conventional, gravity fed.

INITIAL SITE SKETCH

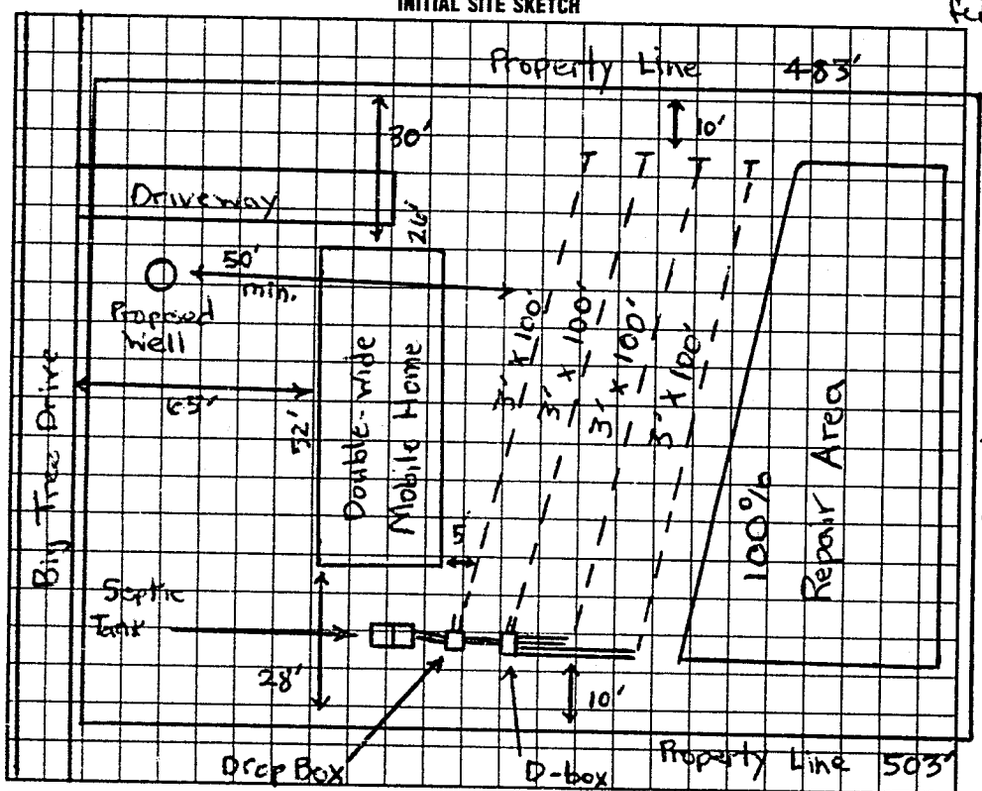

AS BUILT SKETCH

SAME AS INITIAL SKETCH

- fed first line out of D-box first, last two lines last equally.

I understand that this permit can be suspended or revoked if any false information is supplied toward securing the permit/any unauthorized changes are made to the site/any unauthorized changes are made in the installation of the system. Improvement Permit is valid for 60 months from date of issuance.

X Signed: [signature]

Improvement Permit by: Michael J. Dennis date 11-1-94

Existing System Inspection by: date

Installed by: Tommy Cothren's Backhoe

Certificate of Completion by: Michael J. Dennis date 11-2-94

Operation Permit by date

HEALTH DEPT COPY: WHITE INSPECTION COPY (FINAL): GREEN OWNER COPY (FINAL): YELLOW INSPECTION COPY (INITIAL): PINK OWNER COPY (INITIAL): GOLD