IREDELL COUNTY HEALTH DEPARTMENT

STATESVILLE 704-878-5305 MOORESVILLE 704-664-5281

56938

IMPROVEMENT PERMIT / CERTIFICATE OF COMPLETION / OPERATION PERMIT / EXISTING SYSTEM INSPECTION

PROPERTY DESCRIPTION NO. 20721 DATE 7-31-95 TAX MAP NO. 3Q-6-A-29 Watershed: ☐ Yes ☑ No

OWNER OR CONTRACTOR Sun-Wood Bldrs. PHONE: Business 872-0922 Home

ADDRESS 2112 Newton Drive Statesville, N.C. 28677

LOCATION I-40W TL Old Mtn. Rd. TR Buffalo Shoals Rd TR Eufola Rd. TR Big Tree Dr at end on R (Last lot)

SUBDIVISION Woodland Acres BLOCK / SECTION 2 LOT 29 LOT AREA 8.73 acres SITE CLASS. P.S. DESIGN FLOW 360 L.T.A.R. .32 gpd/ft²

Septic Tank: 1000 Gallons; STB — Date —

Pump Tank: — Gallons; PT — Date —

Pump Make: — Model — Serial No. —

Nitrification Field: No Fields 1 Square Feet 1125 Linear Feet 375'

No Lines 4 Trench Width 36" Max Trench Bottom Depth 24"

☑ New System ☐ Repair System Type: I, II, III, IV, V, VI

System Description: conventional, gravity fed

Repair System Description: " "

Maintenance Agreement Required: ☐ Yes ☑ No

Gravel Depth 12"

☐ House/Mod. Home No. Bedrooms 3

☑ Mobile Home No. Bathrooms 2

☐ Business No. Employees —

☐ Other —


☐ Slab ☑ Crawl Space ☐ Basement w/plumbing ☐ Basement wo/plumbing

Water Supply: ☑ Individual ☐ Community ☐ Public

Comments: INSTALL SYSTEM SHALLOW (no deeper than 24" to trench bottom) Keep lines and trenches on contour. Keep system min 5' from foundation of home, 10' from all property lines, and max. feasable distance from any well and no closer than 50'. 100% Repair Above and below

Comments: Well not located at time of inspection. Keep well max. feasible distance from any part of septic system and repair area, and no closer than 50'

INITIAL SITE SKETCH system, conventional, gravity fed.

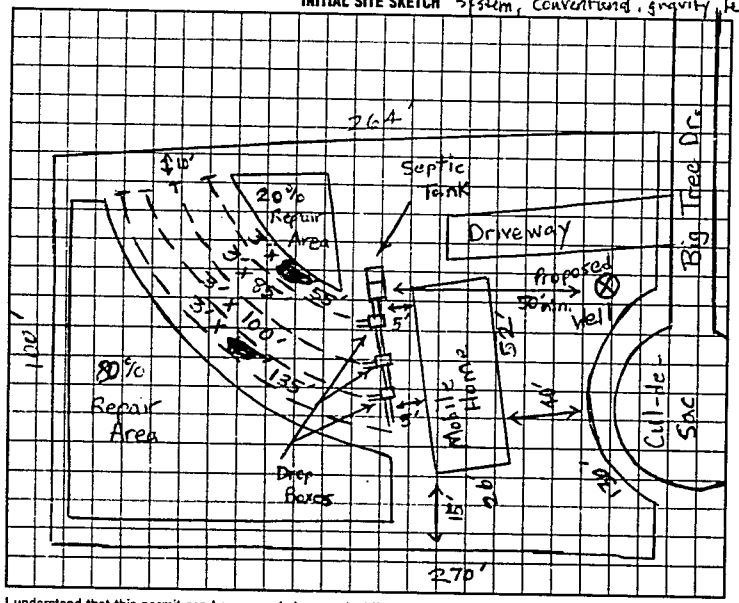

AS BUILT SKETCH

SAME AS INITIAL SKETCH

I understand that this permit can be suspended or revoked if any false information is supplied toward securing the permit/any unauthorized changes are made to the site/any unauthorized changes are made in the installation of the system. Improvement Permit is valid for 60 months from date of issuance.

Signed: [signature]

Improvement Permit by: Michael J. Dennis date 7-31-95

Existing System Inspection by: — date —

Installed by: Tommy Cothren

Certificate of Completion by: Michael J. Dennis date 8-16-95

Operation Permit by: — date —

HEALTH DEPT. COPY: WHITE INSPECTION COPY (FINAL) GREEN OWNER COPY (FINAL) YELLOW INSPECTION COPY (INITIAL) PINK OWNER COPY (INITIAL) GOLD

26100