IREDELL COUNTY HEALTH DEPARTMENT

STATESVILLE 704-878-5305 MOORESVILLE 704-664-5281

IMPROVEMENT PERMIT / CERTIFICATE OF COMPLETION / OPERATION PERMIT / EXISTING SYSTEM INSPECTION

PROPERTY DESCRIPTION NO. 065581 DATE 4-22-97

OWNER OR CONTRACTOR Sunwest Builders TAX MAP NO. Pin No: 4712648811 Watershed: ☑ Yes ☐ No

ADDRESS PO Box 5344 Sta PHONE: Business 872-0922 Home

LOCATION Buffalo Shoals TR Eufola TR Big Tree TR Gloria Brook at end left WSIV-PA

SUBDIVISION Woodhaven BLOCK / SECTION LOT 41 LOT AREA 1.69 acres SITE CLASS. PS DESIGN FLOW 360 L.T.A.R. .13

Septic Tank: 1000 Gallons; STB 1012 Date 6-7-97

Pump Tank: Gallons; PT Date

Pump Make: Model Serial No.

Nitrification Field: No Fields 1 Square Feet 1200 Linear Feet 400

No Lines 4 Trench Width 36" Max Trench Bottom Depth 36" Gravel Depth 12"

☑ New System ☐ Repair System Type: I, II, III, IV, V, VI

System Description: Conv. Gravity

Repair System Description:

Maintenance Agreement Required: ☐ Yes ☑ No

☐ House/Mod. Home No. Bedrooms 3

☑ Mobile Home No. Bathrooms 2

☐ Business No. Employees

☐ Other


☐ Slab ☐ Crawl Space ☐ Basement w/plumbing ☐ Basement wo/plumbing

Water Supply: ☑ Individual ☐ Community ☐ Public


Comments:

Comments:

INITIAL SITE SKETCH

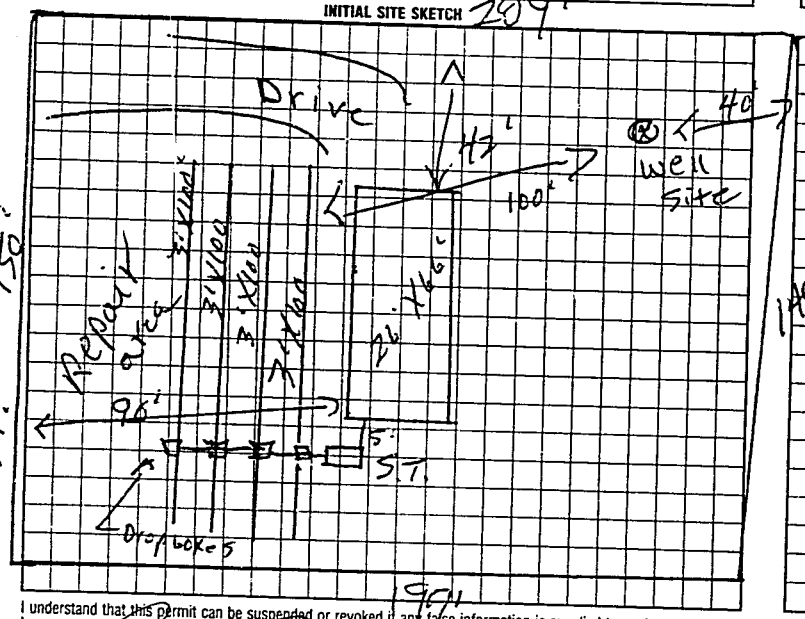

AS BUILT SKETCH

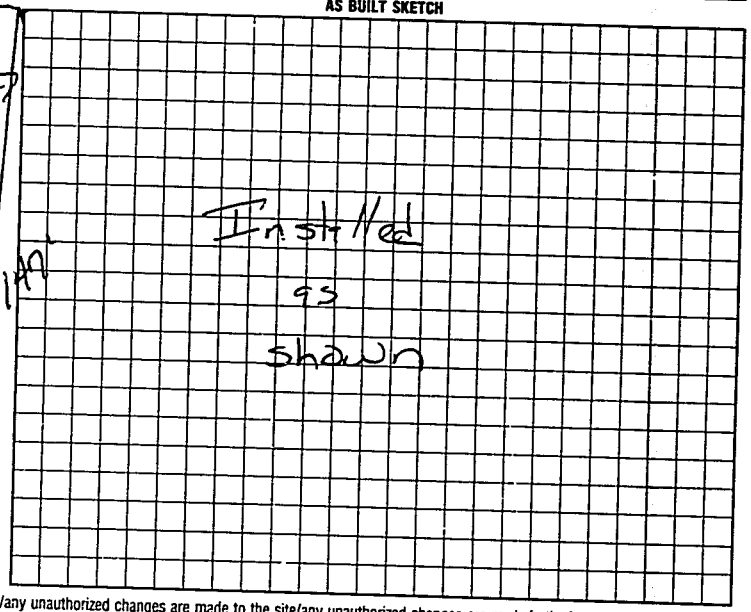

I understand that this permit can be suspended or revoked if any false information is supplied toward securing the permit/any unauthorized changes are made to the site/any unauthorized changes are made in the installation of the system. Improvement Permit is valid for 60 months from date of issuance.

Signed:

Improvement Permit by: R.C. Moore date 4-22-97

Existing System Inspection by: R.C. Moore date 4-22-97

Installed by: Tommy Fryl

Certificate of Completion by: date

Operation Permit by: date 8-15-97

HEALTH DEPT COPY: WHITE INSPECTION COPY (FINAL) GREEN OWNER COPY (FINAL) YELLOW INSPECTION COPY (INITIAL) PINK OWNER COPY (INITIAL) BLUE

to Court. Authorization to Court EXPIRES 60 MOS FROM ISS