IREDELL COUNTY HEALTH DEPARTMENT

STATESVILLE 704-878-5305 MOORESVILLE 704-664-5281

IMPROVEMENT PERMIT / AUTHORIZATION TO CONSTRUCT / OPERATION PERMIT / EXISTING SYSTEM INSPECTION

PERMIT# 075568 PIN# 4712 64 9926 DATE 9-9-98

OWNER OR CONTRACTOR WAYNE C. JENKINS PHONE: Business Home 872-0921

ADDRESS P.O. BOX 5877, STATESVILLE, NC 28687

LOCATION BUFFALO SHOALS RD, TR EUFOLA RD, TR BIG TREE, TR GLORIA BROOK AT END ON RIGHT

SUBDIVISION WOODLAND ACRES BLOCK / SECTION LOT 42 LOT AREA AMPLE SITE CLASS. PS DESIGN FLOW 360 L.T.A.R. 0.25 GPD/FT²

Septic Tank: 1000 Gallons; STB 1012 Date [illegible]68

Pump Tank: Gallons; PT Date 6-21-93

Pump Make: Model Serial No.

Nitrification Field: No Fields 1 Square Feet 1440 Linear Feet 360

No Lines SIX Trench Width 36" Max Trench Bottom Depth 36"

☑ New System ☐ Repair System Type: I, II, III, IV, V, VI

System Description: 25% REDUCTION GRAY

Repair System Description: 25% ~~REDUCTION~~ GRAY

Maintenance Agreement Required: ☐ Yes ☑ No

~~Gravel~~ Depth SAND 6"

☐ House/Mod. Home ☑ Mobile Home ☐ Business ☐ Other


No. Bedrooms 3 No. Bathrooms 2 No. Employees

☐ Slab ☑ Crawl Space ☐ Basement w/plumbing ☐ Basement wo/plumbing


Water Supply: ☑ Individual ☐ Public ☐ Community

Comments:/Conditions: ① INSTALL 25% REDUCTION SYSTEM USING SIXTY CHAMBERS OR 36 HDS SECTIONS ③ USE ONE FLOW DIVIDER TEE TO ACHIEVE EQUAL DISTRIBUTION INTO TWO SETS OF ~~DROP~~ BOXES FEEDING THREE LINES EACH.

INITIAL SITE SKETCH SCALE: 1"=40'

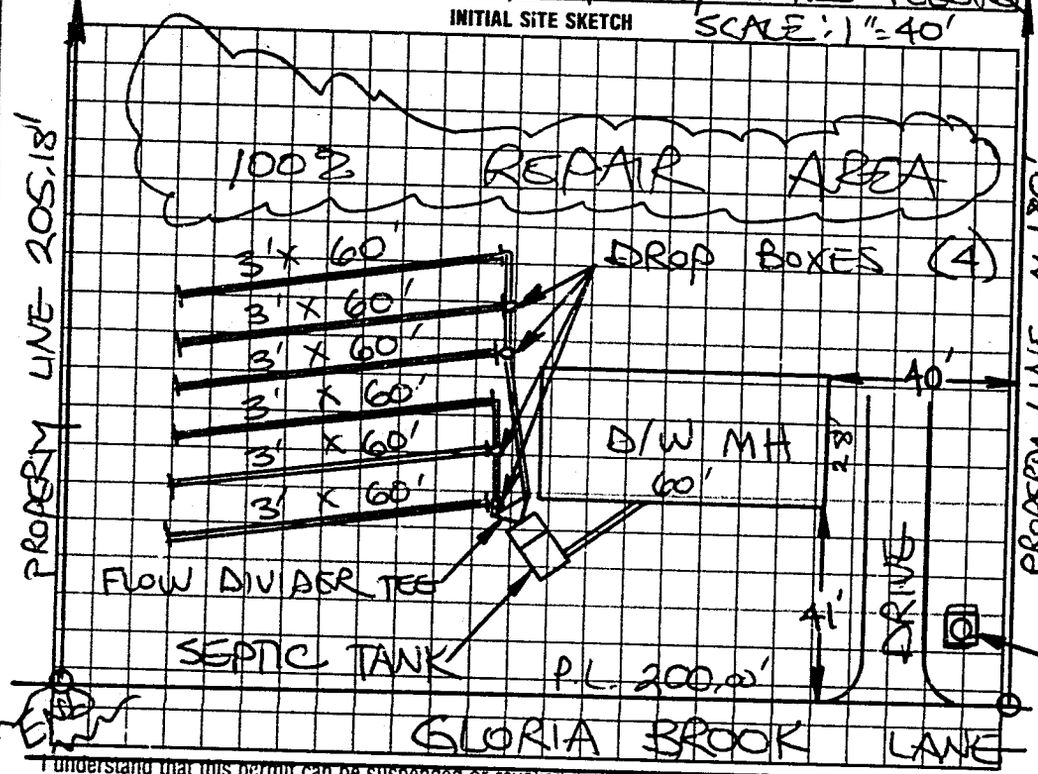

AS BUILT SKETCH

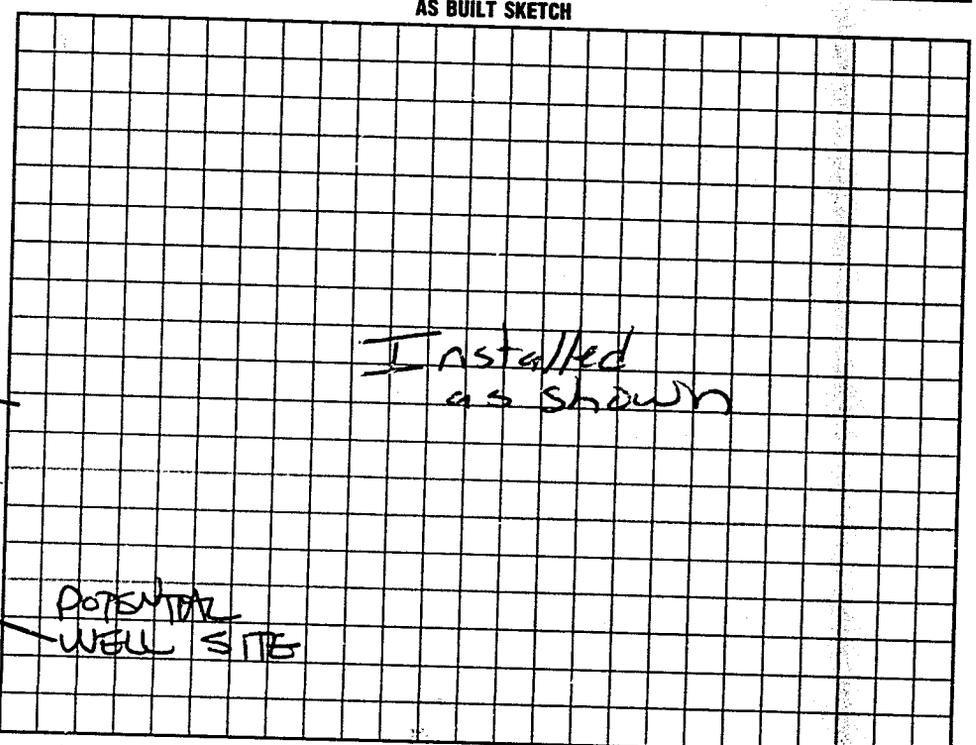

I understand that this permit can be suspended or revoked if any false information is supplied toward securing the permit/any unauthorized changes are made to the site/any unauthorized changes are made in the installation of the system. Improvement Permit with plat valid without expiration. Improvement Permit with site plan valid for sixty months. Authorization to Construct is valid for a period equal to that of Improvement Permit – not to exceed sixty months.

Signed: Wayne W Jenkins date 9/14/98

Improvement Permit by: STEVE HEDRICK date 9-9-98

Authorization to Construct by: STEVE HEDRICK date 9-9-98

Installed by: Tommy Frye

Operation Permit by: Mark C. Dotts date 10-12-98

Existing System Inspection by: date

HEALTH DEPT. COPY: WHITE INSPECTION COPY (FINAL) GREEN OWNER COPY (FINAL) YELLOW INSPECTION COPY (INITIAL) PINK OWNER COPY (INITIAL) GOLD