IREDELL COUNTY HEALTH DEPARTMENT

STATESVILLE 704-878-5305 MOORESVILLE 704-664-5281

IMPROVEMENT PERMIT / AUTHORIZATION TO CONSTRUCT / OPERATION PERMIT / EXISTING SYSTEM INSPECTION

PERMIT# REPAIR PIN# 4712-73-8429 DATE 4-23-03

OWNER OR CONTRACTOR WILLI WOKATSCH PHONE: Business Home 704-528-1614

ADDRESS 141 BACKCREEK ROAD, STATESVILLE, NC 28677

LOCATION BUFFALO SHOALS ROAD TR BACKCREEK ROAD, 2ND HOUSE ON LEFT AT #141

SUBDIVISION STAFFORD EST BLOCK / SECTION LOT 2 LOT AREA 4.62 ACRES SITE CLASS. PS DESIGN FLOW 480 L.T.A.R. EXISTING

Septic Tank: EXISTING Gallons; ST8 Date

Pump Tank: Gallons; PT Date

Pump Make: Model Serial No.

Nitrification Field: No Fields Square Feet Linear Feet EXISTING

No Lines 2 Trench Width Max Trench Bottom Depth Gravel Depth

~~New System~~ ☑ Repair System Type: I (II) III, IV, V, VI

System Description:

Repair System Description: CONVENTIONAL, GRAVITY

Maintenance Agreement Required: ☐ Yes ☑ No

☐ ~~House/Mod. Home~~ No. Bedrooms 4

☐ Mobile Home No. Bathrooms 3

☐ Business No. Employees

☐ Other


☐ Slab ☐ Crawl Space ☑ Basement w/plumbing ☐ Basement wo/plumbing

Water Supply:
☐ ~~Individual~~
☐ Public
☐ Community
WELL


Comments:/Conditions: ① REPLACE EXISTING DISTRIBUTION BOX AT LOCATION SHOWN. ② SYSTEM UNDERSIZED ACCORDING TO TODAY'S STANDARDS

Comments:/Conditions: SEPTIC TANK SHOWS SIGNS OF CRACKING AT CORNERS OF ACCESS LIDS - TANK MAY NEED TO BE REPLACED FOR SAFETY REASONS

INITIAL SITE SKETCH

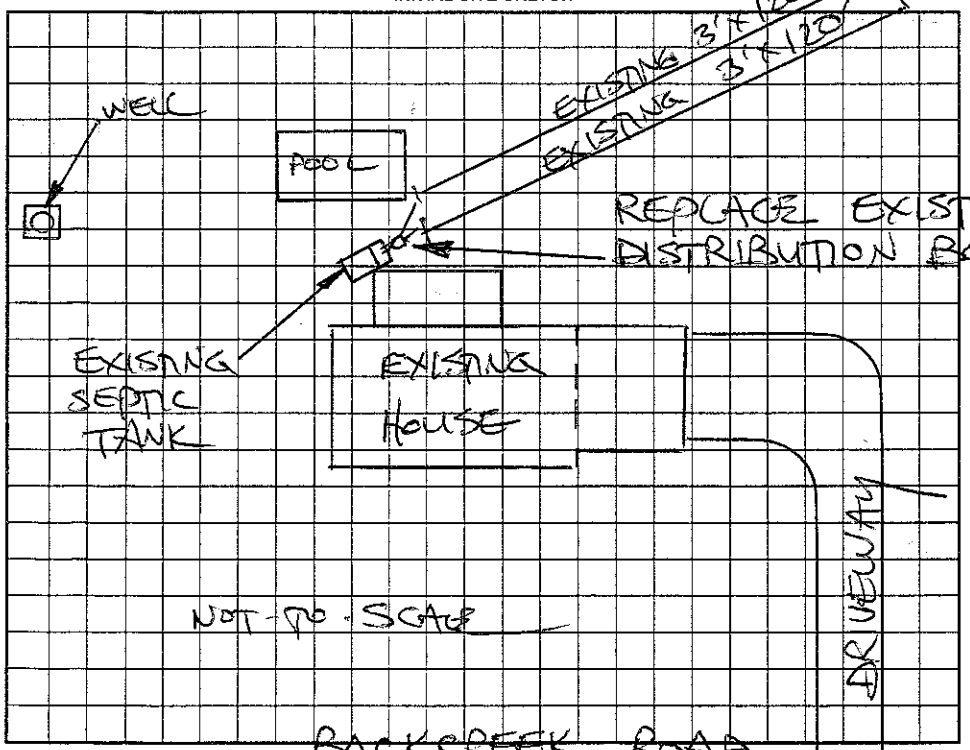

AS BUILT SKETCH

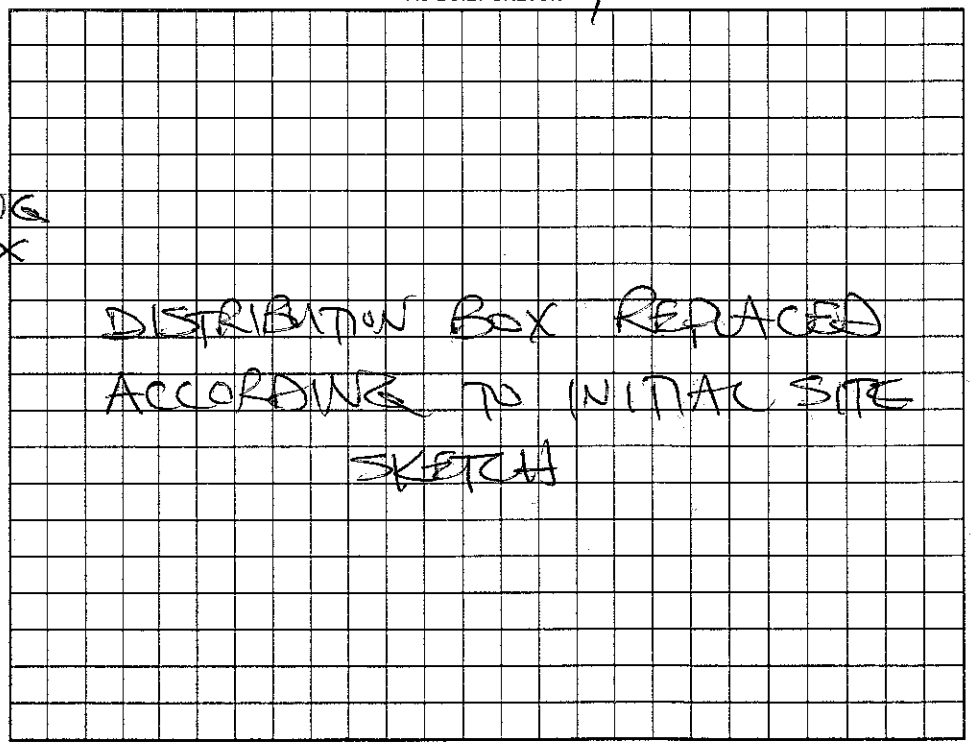

Permit can be suspended or revoked if any false information is supplied toward securing the permit/any unauthorized changes are made to the site/any unauthorized changes are made in the installation of the system. Improvement Permit with plat valid without expiration. Improvement Permit with site plan valid for sixty months. Authorization to Construct is valid for a period equal to that of Improvement Permit – not to exceed sixty months.

Signed: Evelyn Wokatsch date 4-23-03 Installed by: STEVE JORDAN

Improvement Permit by: STEVE HEDRICK date 4-23-03 Operation Permit by: STEVE HEDRICK date 5-12-03

Authorization to Construct by: STEVE HEDRICK date 4-23-03 Existing System Inspection by: date

HEALTH DEPT. COPY: WHITE OWNER COPY (FINAL): YELLOW OWNER COPY (INITIAL): PINK