IREDELL COUNTY HEALTH DEPARTMENT

STATESVILLE 704-878-5305 (C1) MOORESVILLE 704-664-5281

IMPROVEMENT PERMIT / AUTHORIZATION TO CONSTRUCT / OPERATION PERMIT / EXISTING SYSTEM INSPECTION

PERMIT# 116495 PIN# 4712-74-~~4769~~ 2256 DATE 11-6-03

OWNER OR CONTRACTOR BP BUILDERS, INC PHONE: Business 704-902-1344 Home

ADDRESS 123 SULLIVAN FARM ROAD, STATESVILLE, NC 28625

LOCATION BUFFALO SHOALS ROAD, TR BACKCREEK LANE, HOUSE ON LEFT AT #173, BACK OFF ROAD

SUBDIVISION STAFFORD ESTATES BLOCK / SECTION LOT 5 LOT AREA 5.67 ACRES SITE CLASS PS DESIGN FLOW 480 L.T.A.R. 0.30 GPD/FTC

Septic Tank: EXISTING Gallons; STB Date

Pump Tank: Gallons; PT Date

Pump Make: Model Serial No.

Nitrification Field: No Fields 1 Square Feet EX. 400 Linear Feet 100

No Lines TWO Trench Width 36" Max Trench Bottom Depth 36" Gravel Depth N/A

☑ New System ☐ Repair System Type: I, II, (III), IV, V, VI

System Description: 25% REDUCTION, GRAVITY

Repair System Description: 25% REDUCTION, PUMP

Maintenance Agreement Required: ☐ Yes ☐ No

☑ House/Mod. Home No. Bedrooms 4

☐ Mobile Home No. Bathrooms 3

☐ Business No. Employees

☐ Other


☑ Slab ☑ Crawl Space ☐ Basement w/plumbing ☐ Basement wo/plumbing

Water Supply: ☐ Individual ☐ Public ☐ Community


Comments:/Conditions ① INSTALL 25% REDUCTION SYSTEM IN TWO NEW LINES AS SHOWN ② USE THREE NEW DROP BOXES FOR SERIAL DISTRIBUTION AS SHOWN.

Comments:/Conditions:

INITIAL SITE SKETCH

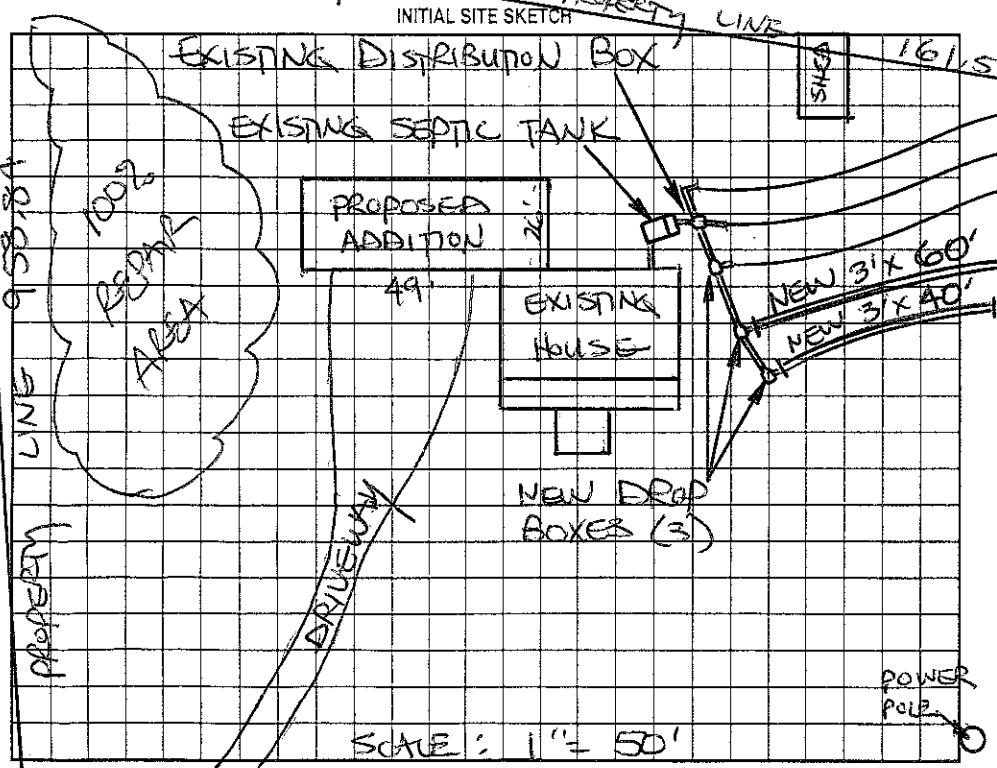

AS BUILT SKETCH

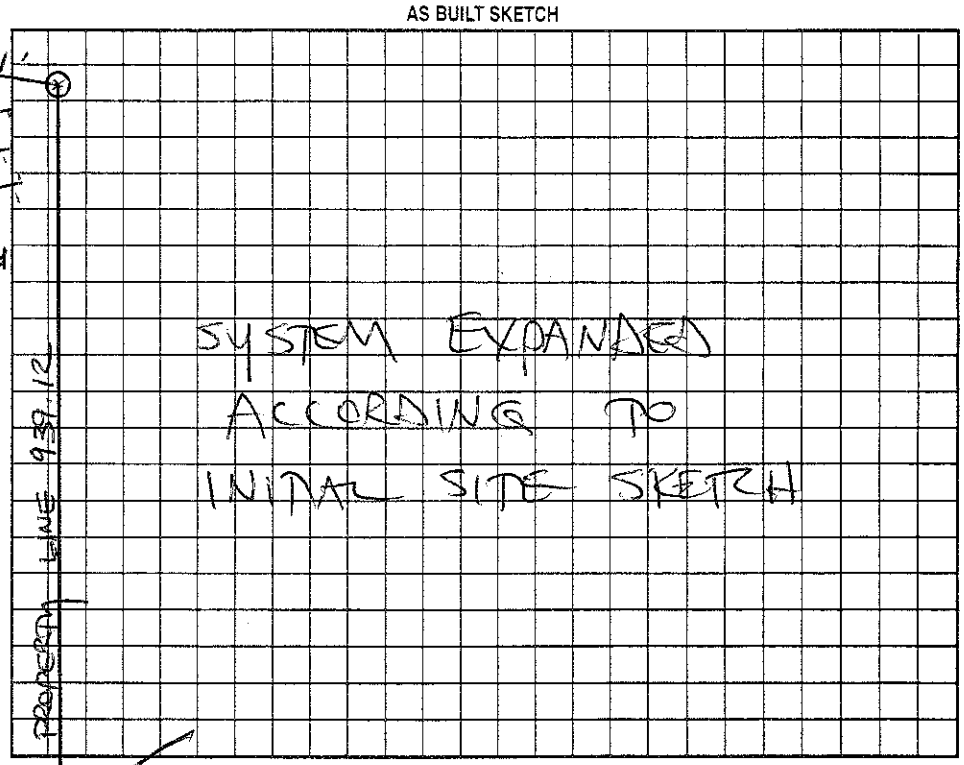

Permit can be suspended or revoked if any false information is supplied toward securing the permit/any unauthorized changes are made to the site/any unauthorized changes are made in the installation of the system. Improvement Permit with plat valid without expiration. Improvement Permit with site plan valid for sixty months. Authorization to Construct is valid for a period equal to that of Improvement Permit – not to exceed sixty months.

Signed: BRANCH date 12-3-03 Installed by: TOMMY FLYE

Improvement Permit by: STEVE HEDRICK date 11-6-03 Operation Permit by: STEVE HEDRICK date 1-13-03

Authorization to Construct by: STEVE HEDRICK date 11-6-03 Existing System Inspection by: date

HEALTH DEPT. COPY: WHITE OWNER COPY (FINAL): YELLOW OWNER COPY (INITIAL): PINK

EXISTING WELL