IREDELL COUNTY HEALTH DEPARTMENT

STATESVILLE 704-878-5305 MOORESVILLE 704-664-5281

IMPROVEMENT PERMIT / AUTHORIZATION TO CONSTRUCT / OPERATION PERMIT / EXISTING SYSTEM INSPECTION

PERMIT # 146895 PIN # 4712 82 1684 DATE 12-8-08

OWNER or APPLICANT JASON & SHERRI LAYNE PHONE: Business 704-942-4991 Home:

OWNER or APPLICANT ADDRESS 1977 Buffalo Shoals Rd Statesville NC 28677

LOCATION / DIRECTIONS BUFFALO SHOALS RD SOUTH WEST ON LEFT AT BOX #1977 PAST EUFOLA RD

SUBDIVISION BLOCK / SECTION LOT # LOT AREA 1.309 AC DESIGN FLOW 240 L.T.A.R. EXISTING

Septic Tank EXISTING Gallons: STB Date

Pump Tank Gallons: P T Date

Pump Make Model Serial #

Nitrification Field No Fields 1 No Lines 4 Linear Feet 150'

Trench Width EXISTING Max. Trench Bottom Depth EXISTING Gravel Depth EXISTING ☒ GRAVITY ☐ PRESSURE

☐ New System ☐ Repair ☐ Expansion System Type I (II) III IV V VI

System Description: CINDERS TERRA COTA TILES

Repair System Description:

Maintenance Agreement Required ☐ YES ☒ NO

☒ Residence No. Bedrooms 2

☐ Business No. Persons

☐ Other No. Employees

☐ Slab ☐ Crawl Space

☐ Basement w/plumbing ☒ Basement w/o plumbing

Water Supply: ☒ Private ☐ Public ☐ Community

Comments / Conditions (1) This is a properly functioning system in use (2) System was probed & building will not affect existing system (3) NO OLD RECORDS FOUND

Comments / Conditions

INITIAL SITE SKETCH

SEE ATTACHED

AS BUILT SKETCH

Permit can be suspended or revoked if any false information is supplied toward securing the permit / any unauthorized changes are made to the site / any unauthorized changes are made in the installation of the system.

☐ *IMPROVEMENT PERMIT w / plat valid without expiration* ☐ *IMPROVEMENT PERMIT w / site plan valid for 60 mos.* ☐ *AUTHORIZATION TO CONSTRUCT valid for period equal to IMPROVEMENT PERMIT-not to exceed 60 mo.*

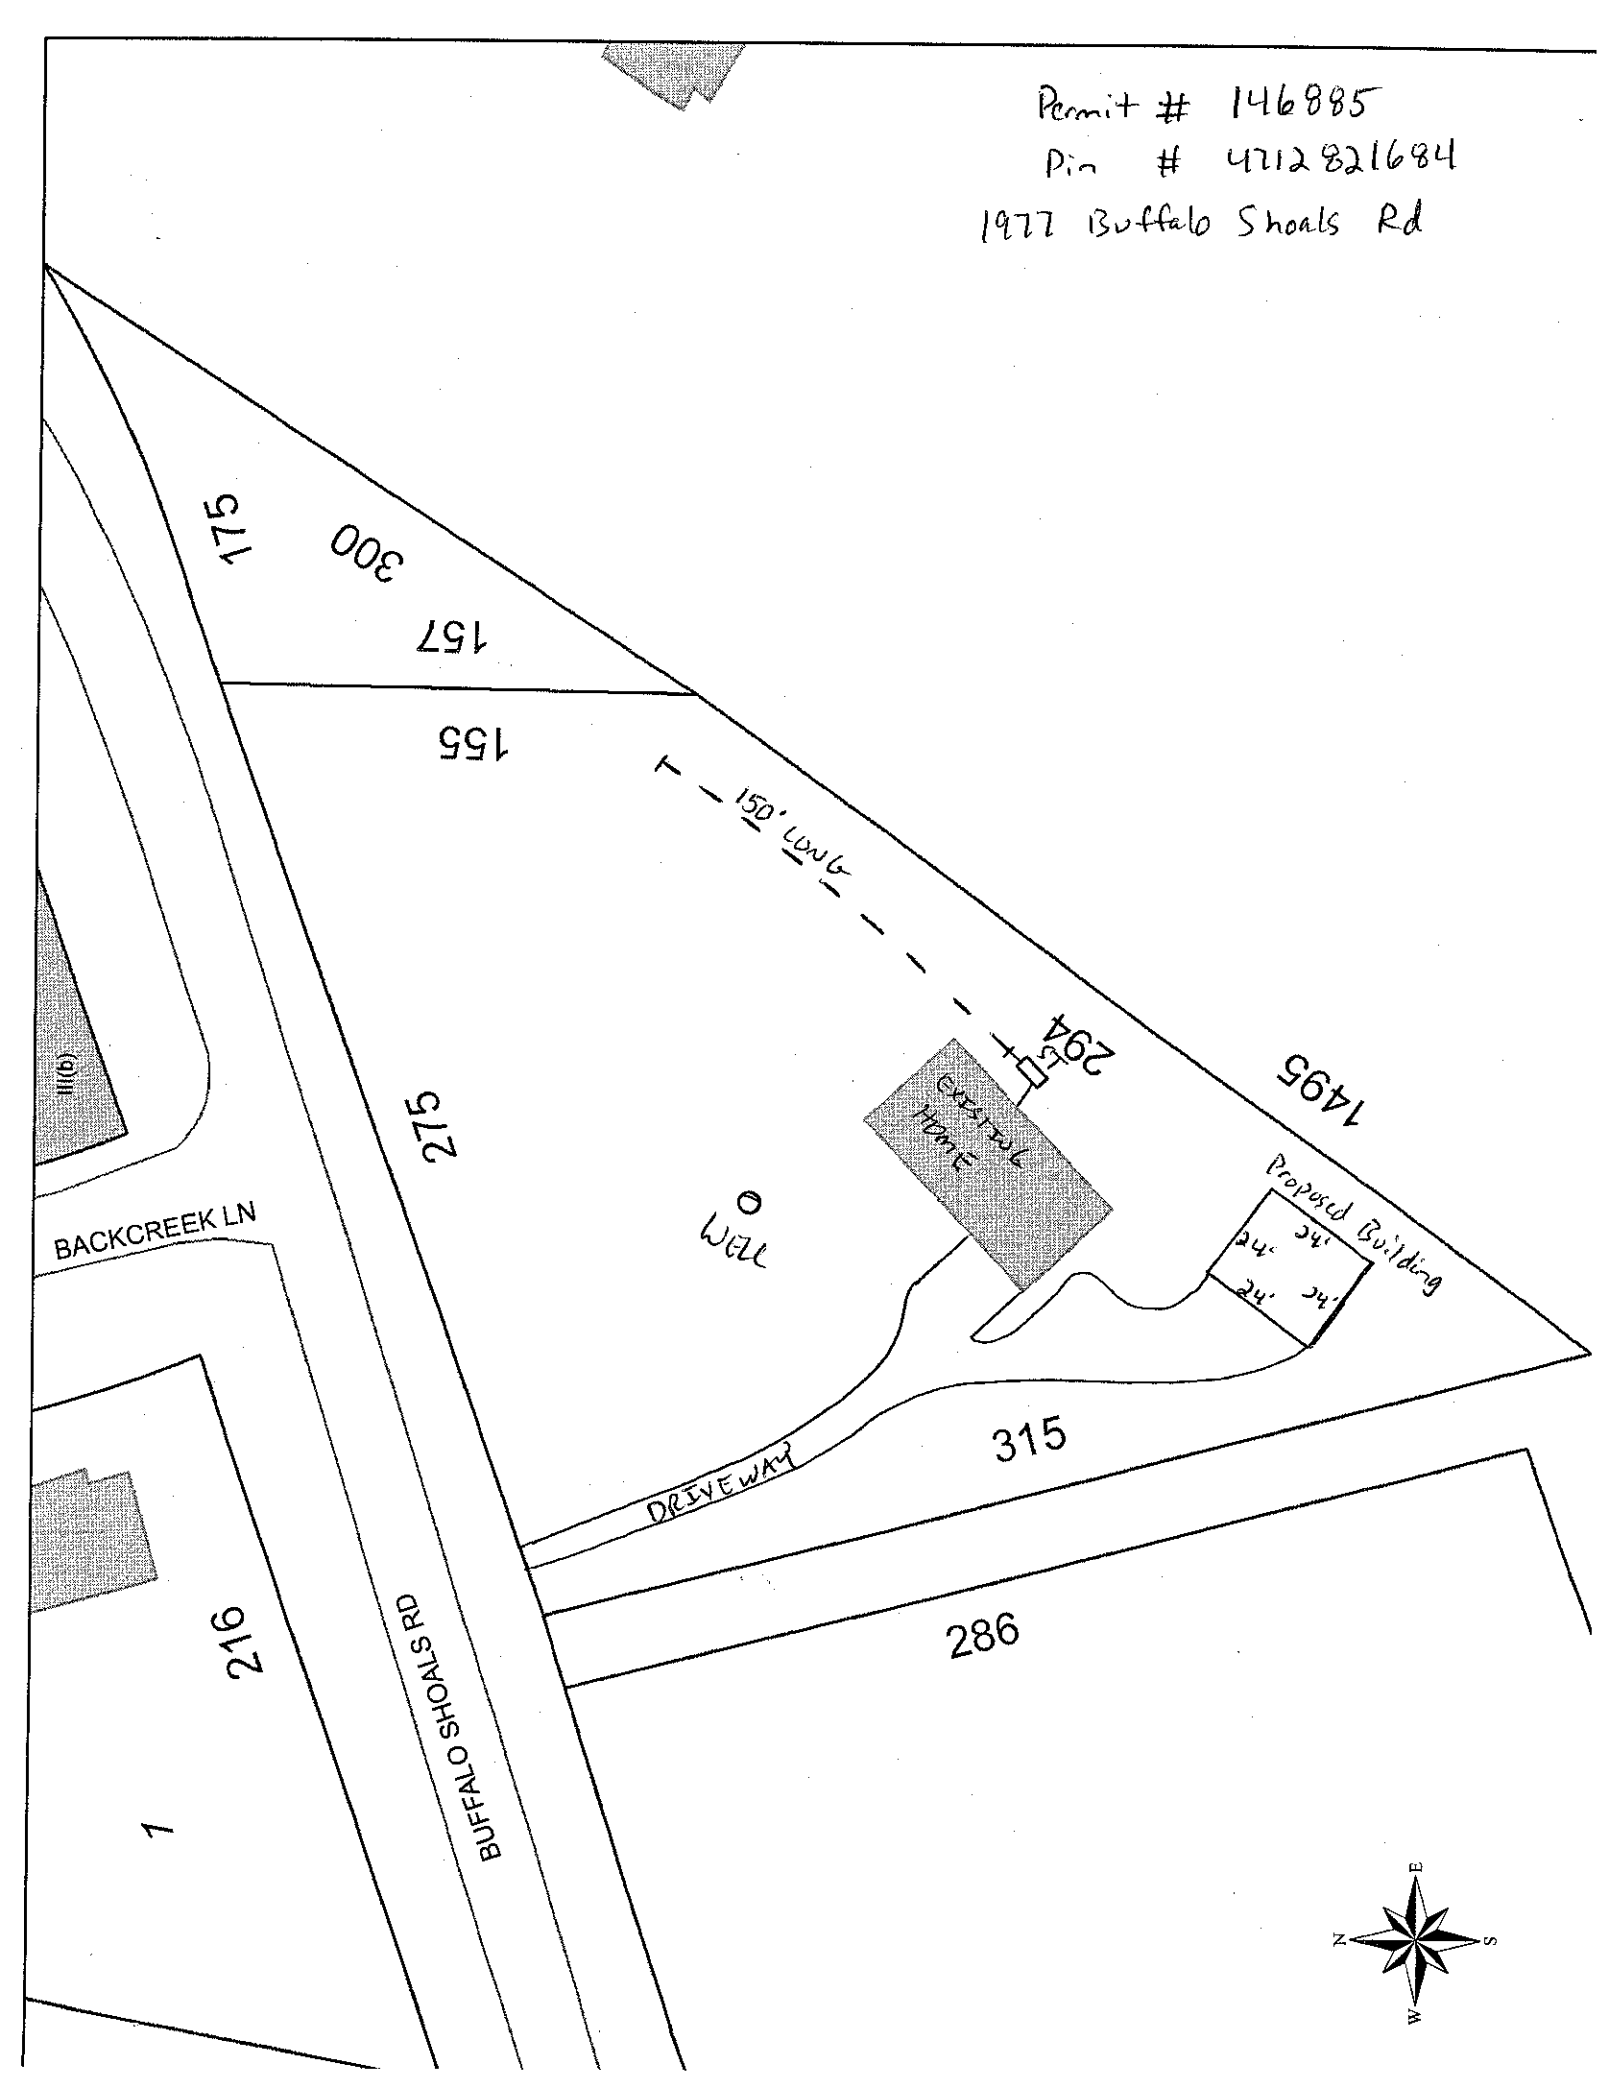
Owner / Applicant Signature: Date 12-12-08 Installed by:

Improvement Permit by: Date Operation Permit by: Date:

Authorzation to Construct by: Date Existing System Inspected by: Date: 12-8-08

YOU SHOULD CONTACT A LOCATOR SERVICE PRIOR TO ANY EXCAVATION.

WHITE COPY Environmental Health YELLOW COPY (Final) Owner / Applicant PINK COPY (Initial) Owner / Applicant


Permit # 146885
Pin # 4712821684
1977 Buffalo Shoals Rd
175
300
157
155
150' Well
294
1495
275
Existing Home
Proposed Building
24'
24'
24'
24'
Well
BACKCREEK LN
DRIVEWAY
315
286
216
1
BUFFALO SHOALS RD
III(b)
N
E
S
W